



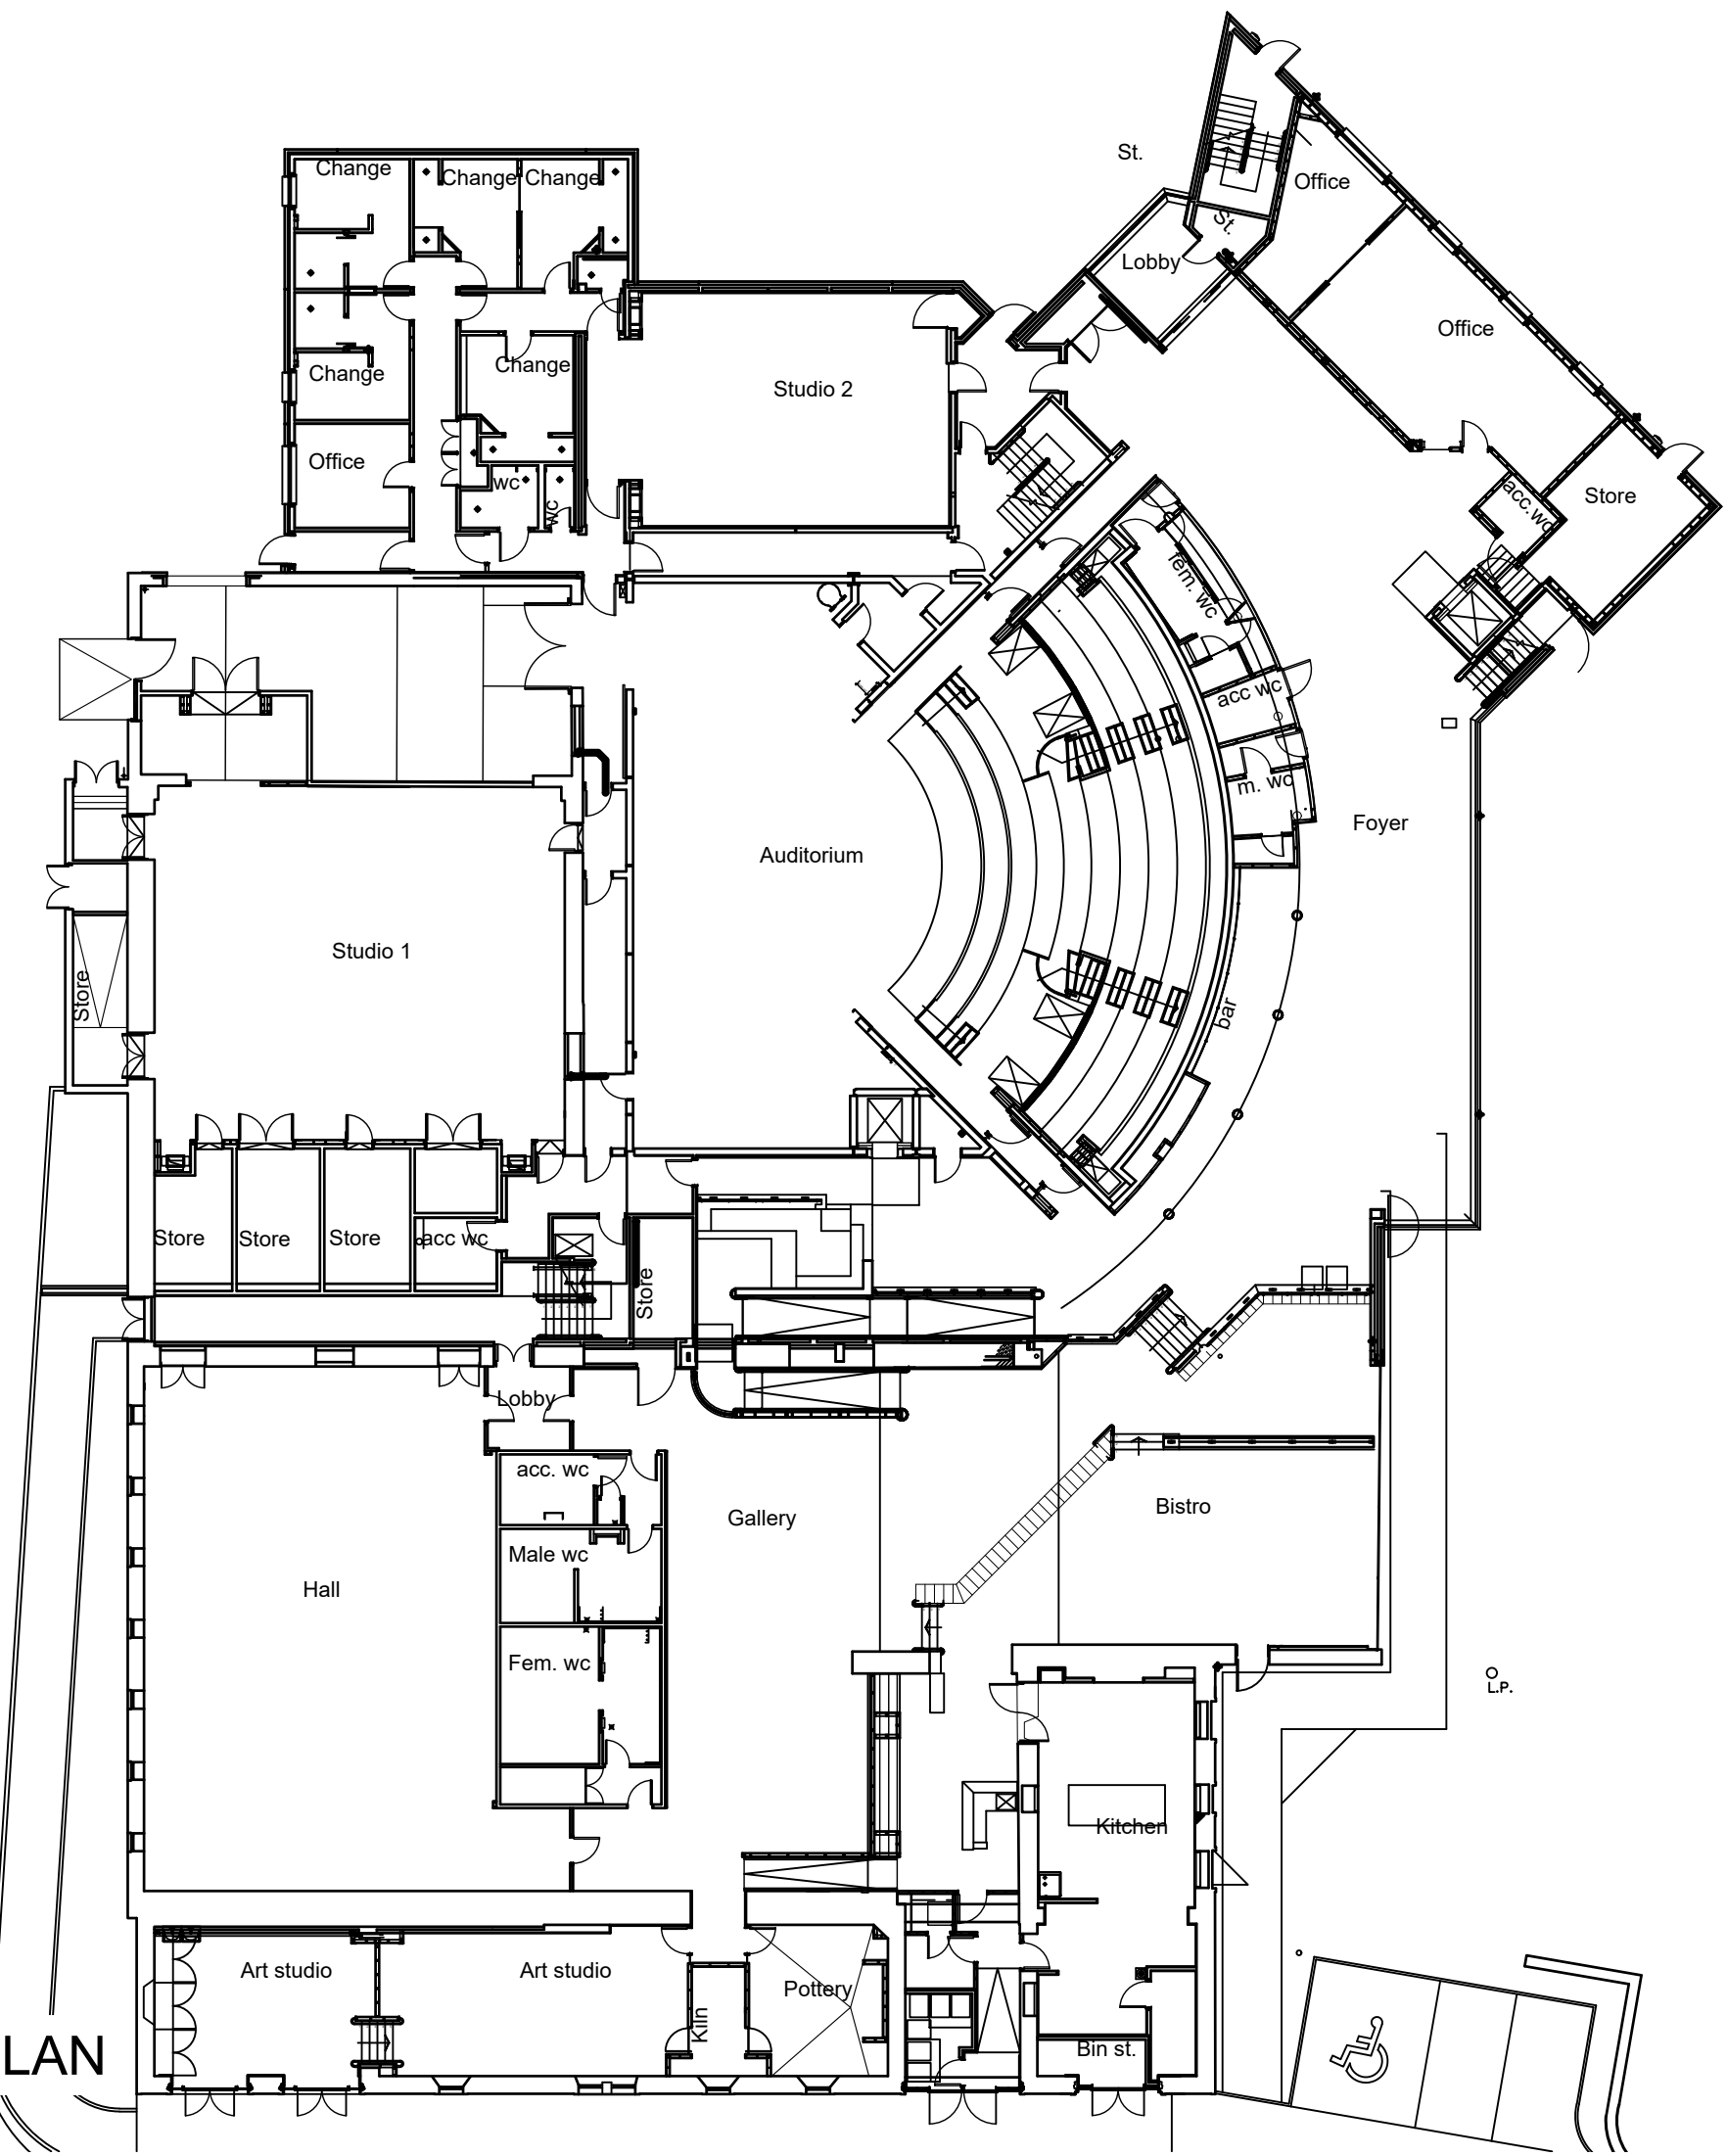

Location Plan

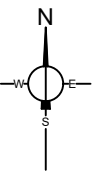

GROUND FLOOR PLAN



GENERAL LAYOUT PLAN

Rev	date	details	A3 sheet
Status			AS BUILT
● all dimensions to be checked on site ● do not scale from drawings			
Property Services West Lothian Civic Centre Howden South Road, Livingston EH54 6FF			
Project HOWDEN PARK CENTRE HOWDEN PARK LIVINGSTON			
Drawing GROUND FLOOR PLAN GENERAL PLAN			
date	JULY'22	scale(s)	1:250
project no.	***	drawn	WMC **
		check	**
		Rev	-

OS Plan reproduced from Ordnance Survey mapping with the permission of the controller of Her Majesty's Stationery Office. Crown Copyright. Unauthorised reproduction infringes Crown copyright and may lead to prosecution or civil proceedings. West Lothian Council copyright license LA9026.



Location Plan

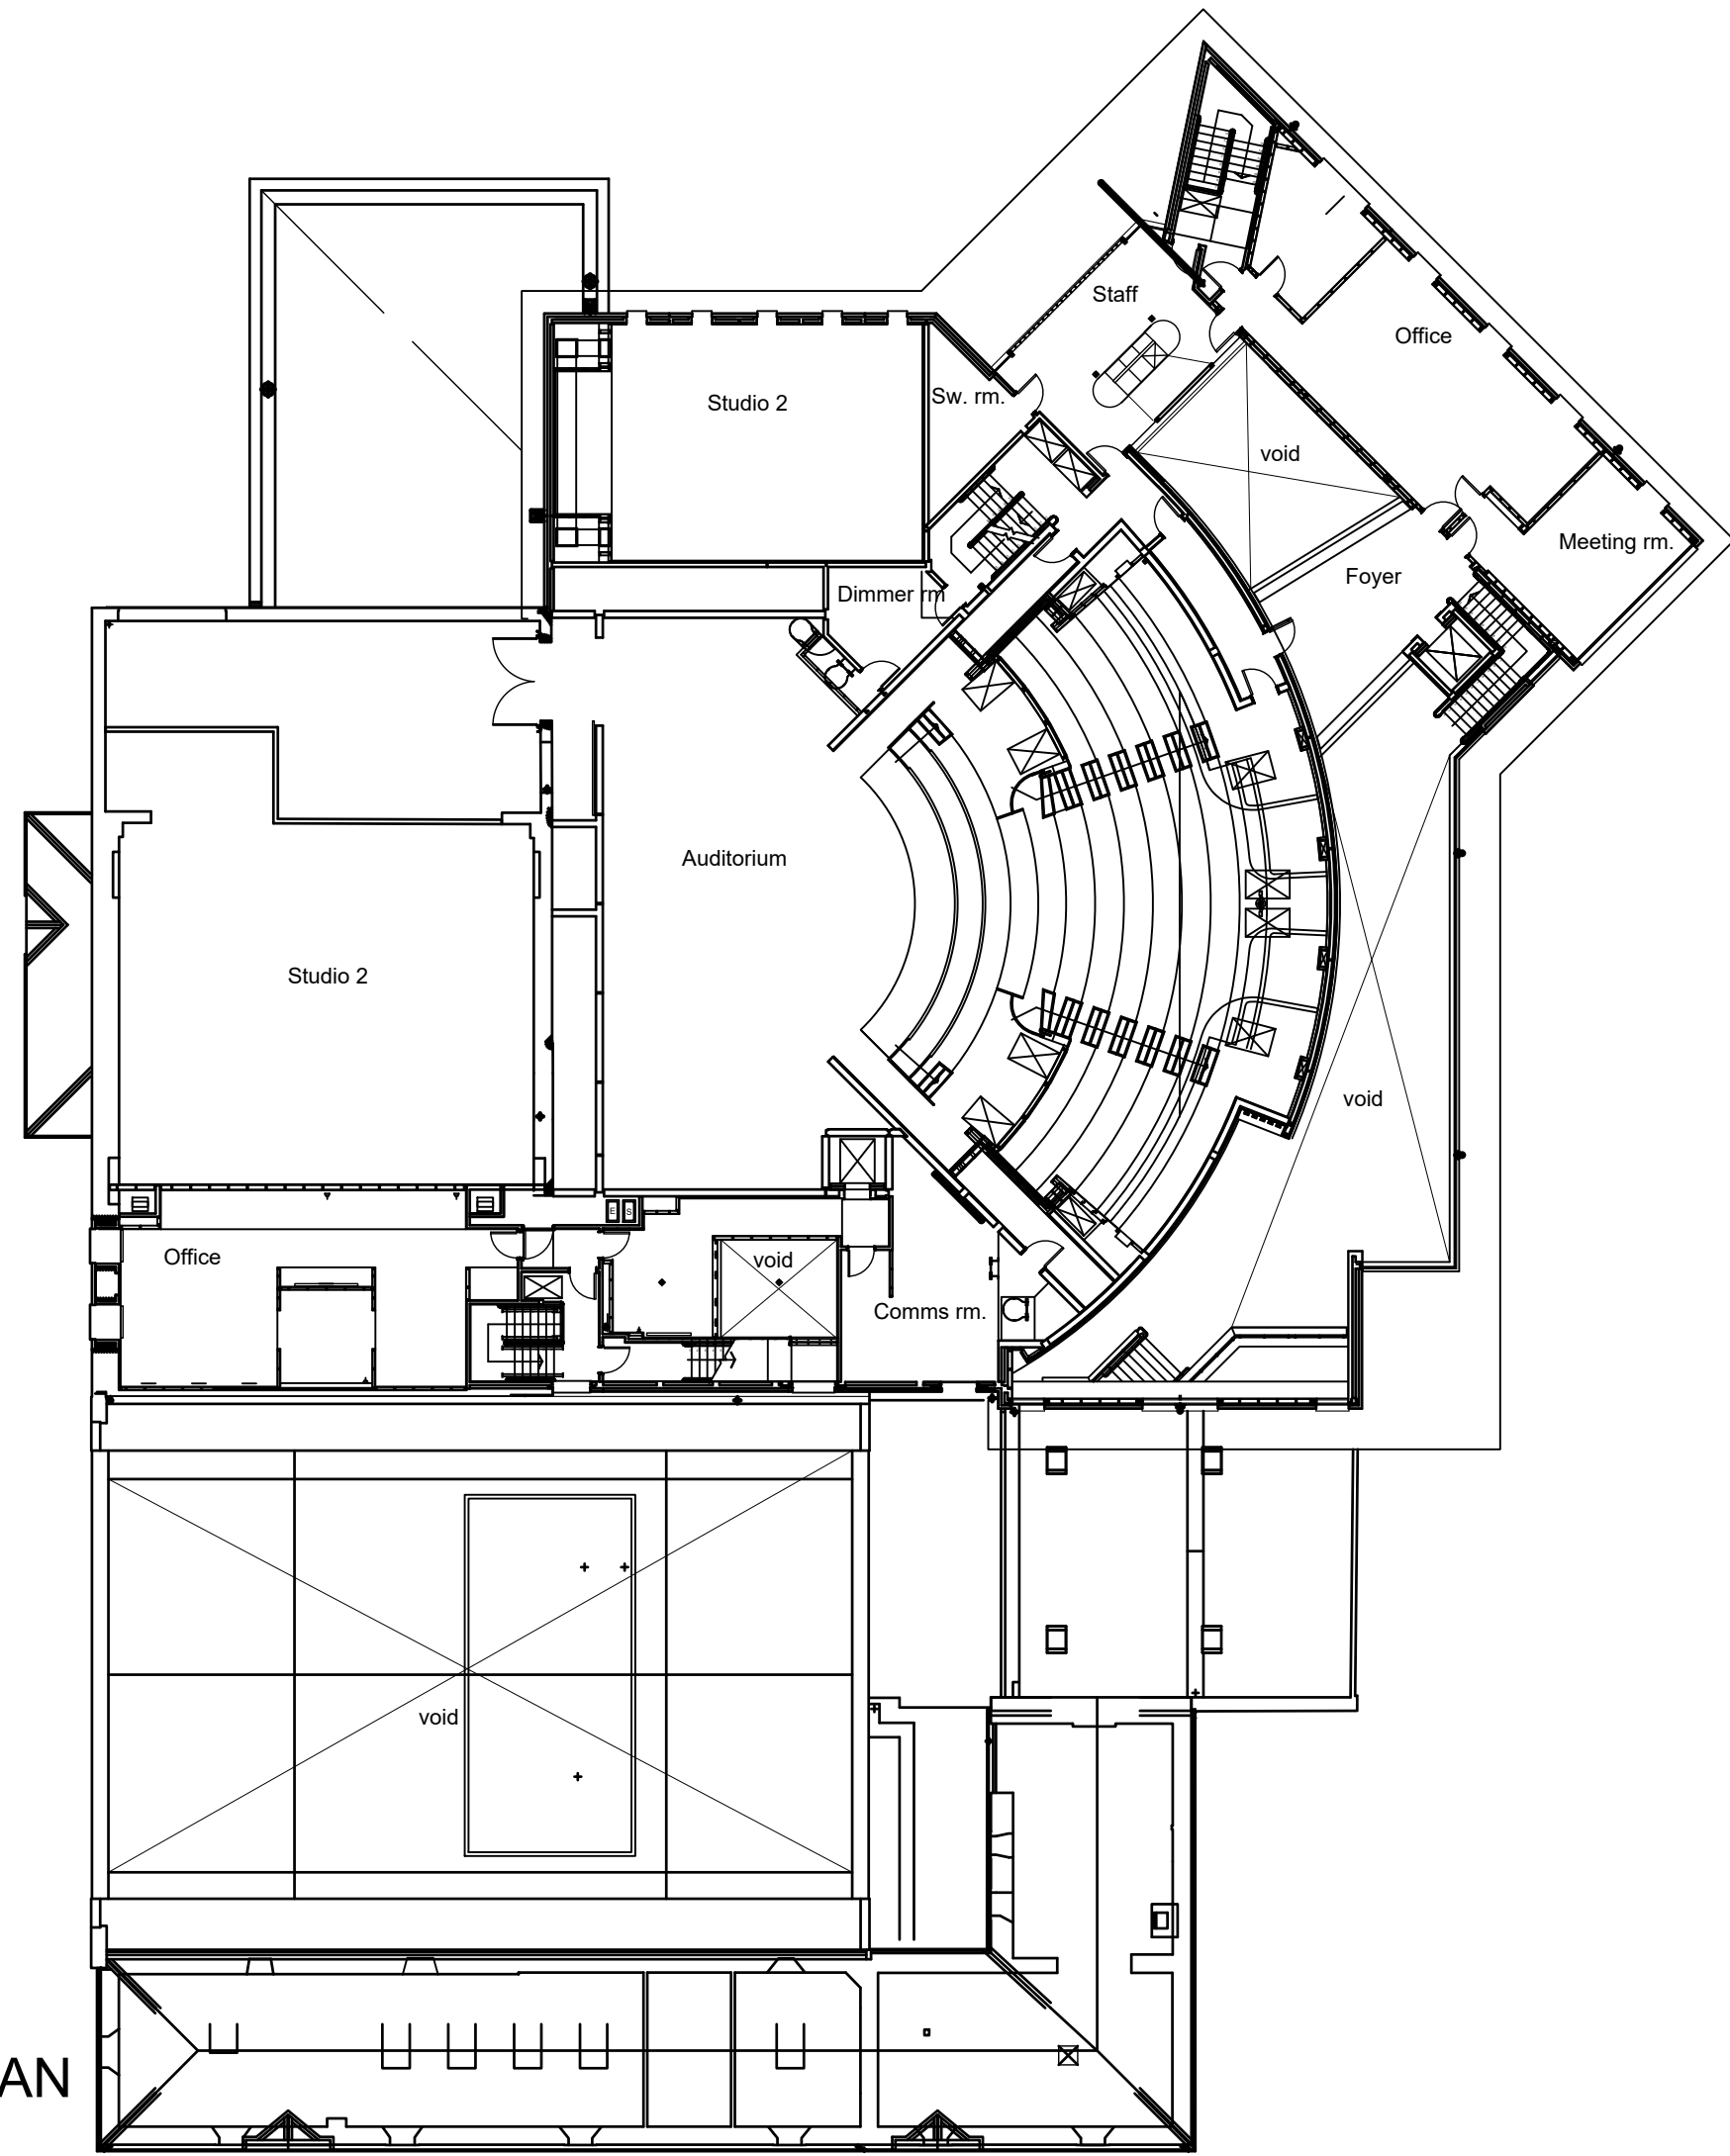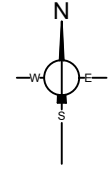

FIRST FLOOR PLAN



GENERAL LAYOUT PLAN

Rev	date	details	A3 sheet
Status			AS BUILT
<p>● all dimensions to be checked on site ● do not scale from drawings</p>			
Property Services West Lothian Civic Centre Howden South Road, Livingston EH54 6FF			
Project HOWDEN PARK CENTRE HOWDEN PARK LIVINGSTON			
Drawing FIRST FLOOR PLAN GENERAL PLAN			
date	JULY'22	scale(s)	1:250
project no.	***	drawing no.	***
drawn	WMC	check	**
Rev	-		

OS Plan reproduced from Ordnance Survey mapping with the permission of the controller of Her Majesty's Stationery Office. Crown Copyright. Unauthorised reproduction infringes Crown copyright and may lead to prosecution or civil proceedings. West Lothian Council copyright license LA9002.



Location Plan

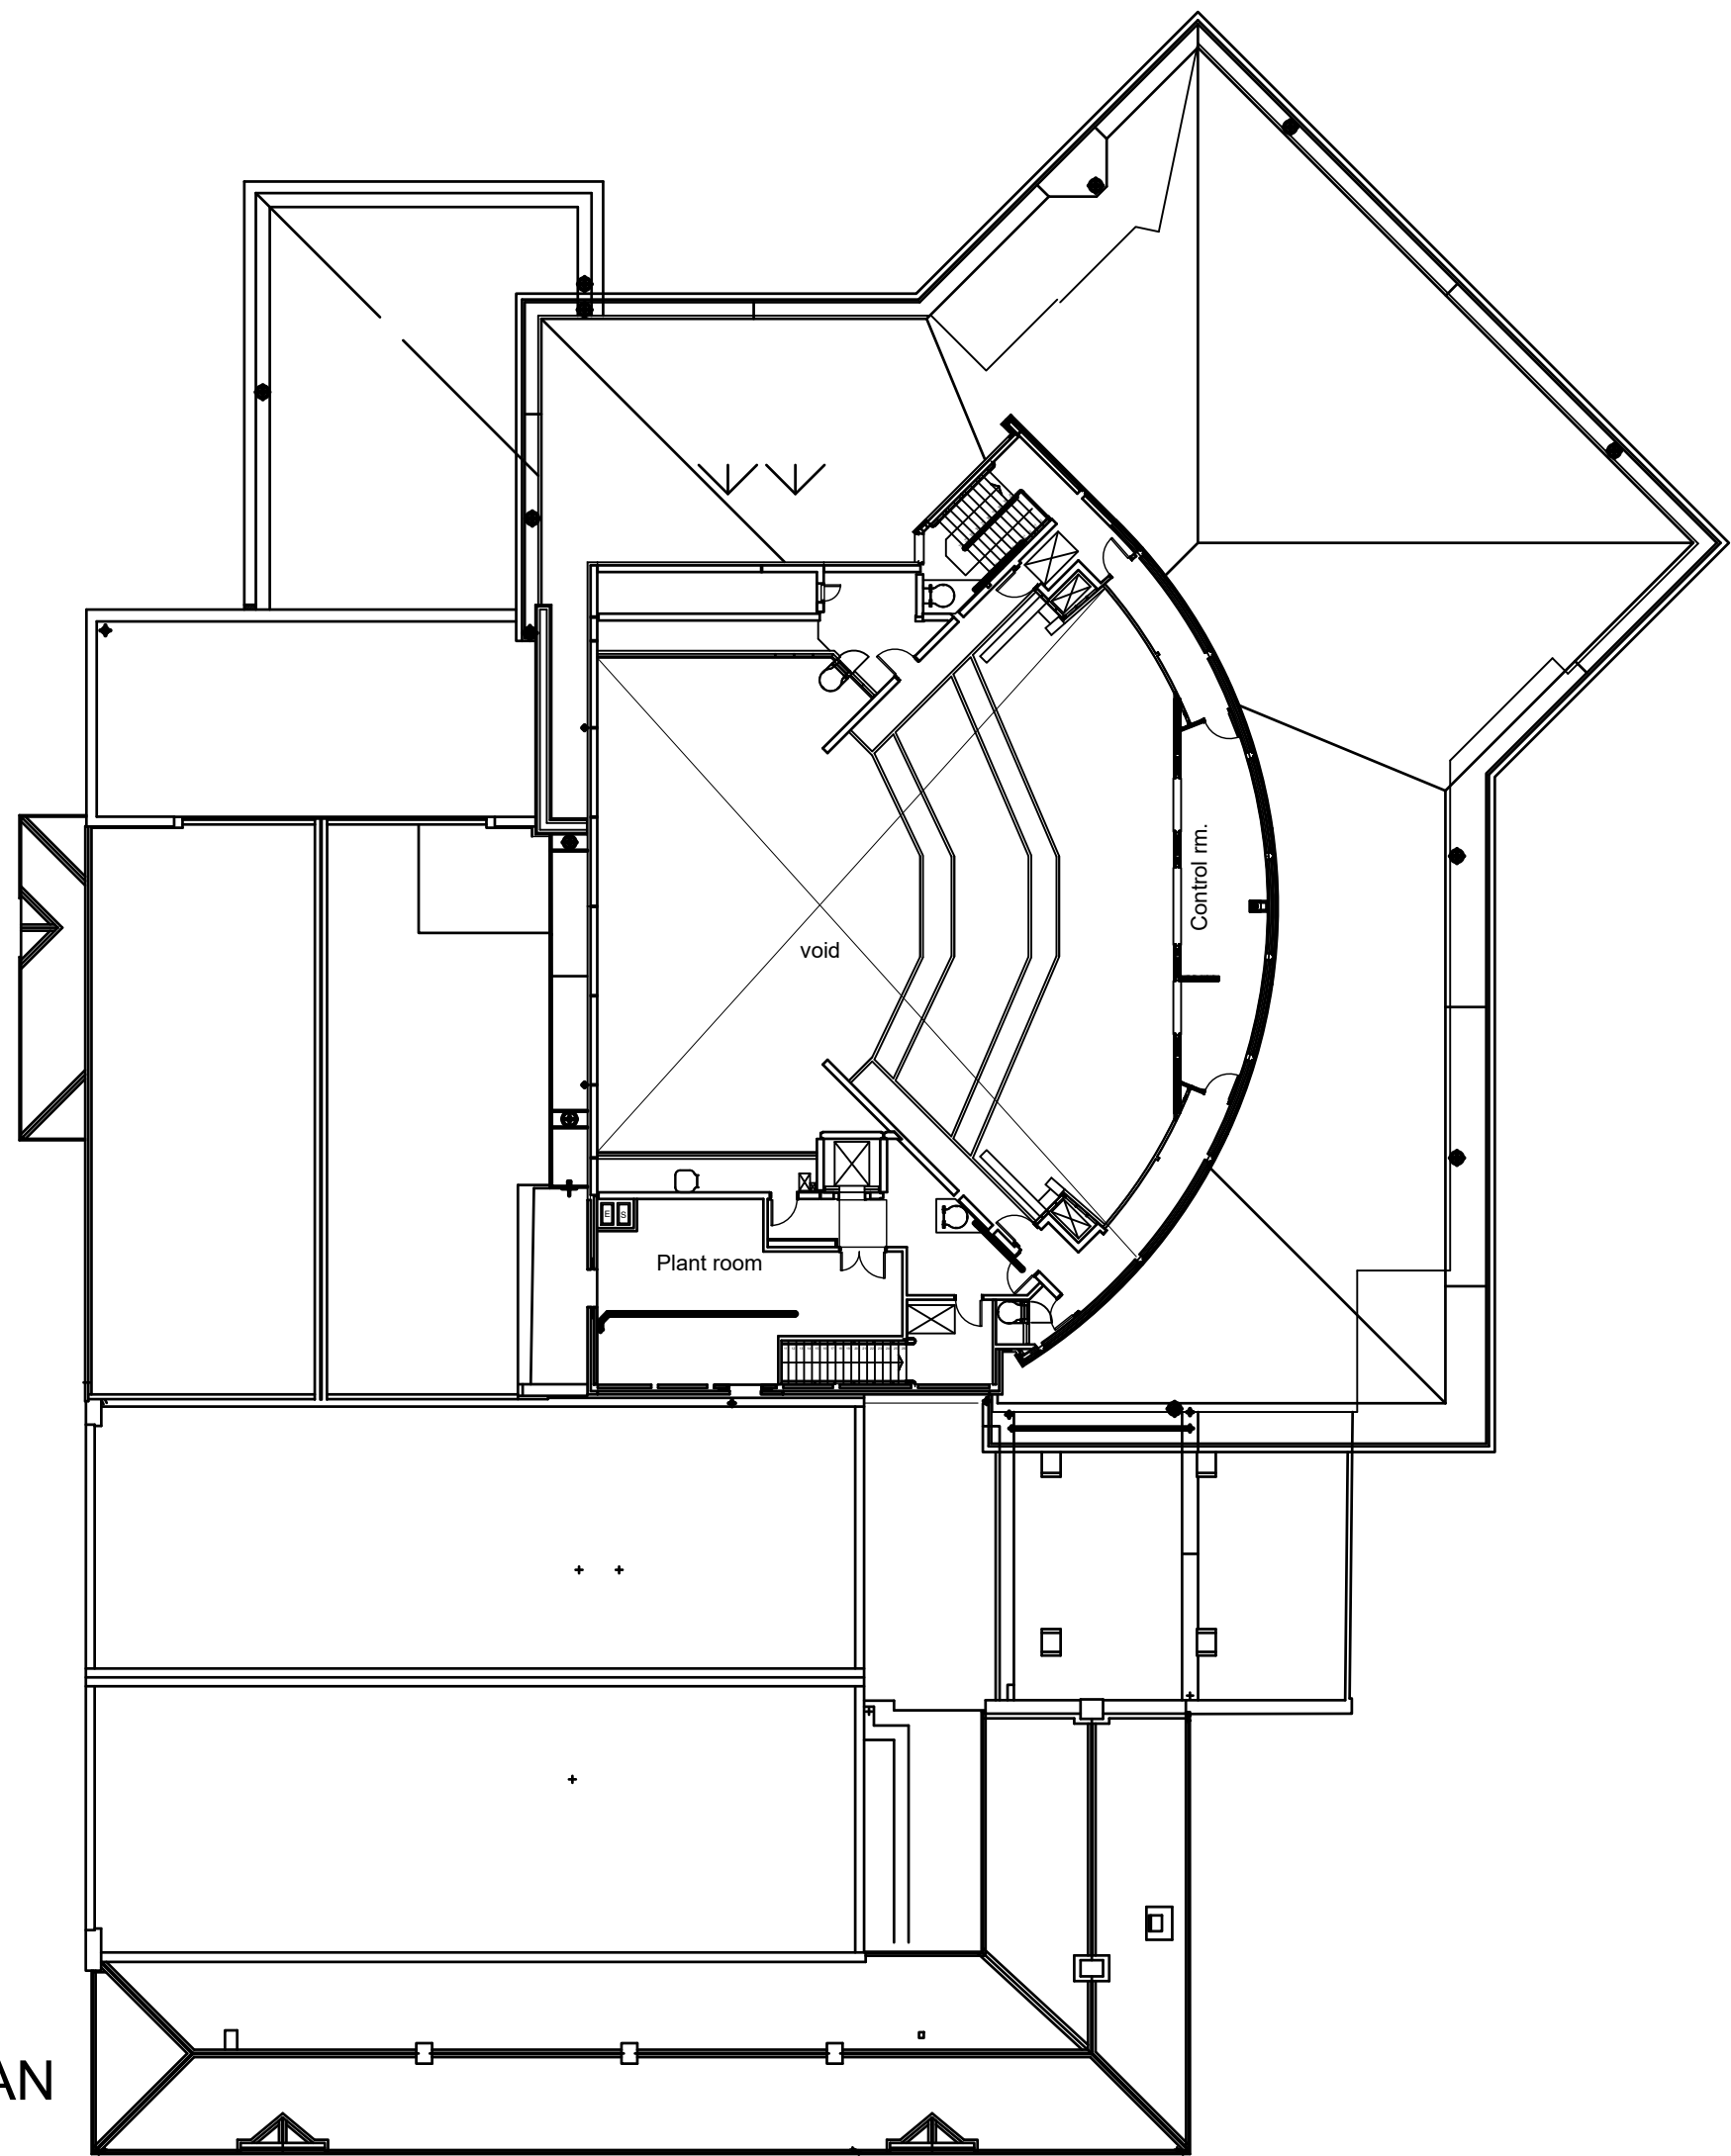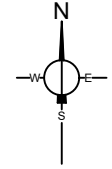

SECOND FLOOR PLAN



GENERAL LAYOUT PLAN

Rev	date	details	A3 sheet
Status			AS BUILT
<p>● all dimensions to be checked on site ● do not scale from drawings</p>			
Property Services West Lothian Civic Centre Howden South Road, Livingston EH54 6FF			
Project HOWDEN PARK CENTRE HOWDEN PARK LIVINGSTON			
Drawing SECOND FLOOR PLAN GENERAL PLAN			
date	JULY'22	scale(s)	1:250
project no.	***	drawn	WMC **
		check	**
		Rev	-

OS Plan reproduced from Ordnance Survey mapping with the permission of the controller of Her Majesty's Stationery Office. Crown Copyright. Unauthorised reproduction infringes Crown copyright and may lead to prosecution or civil proceedings. West Lothian Council copyright licence LA69026.



Location Plan

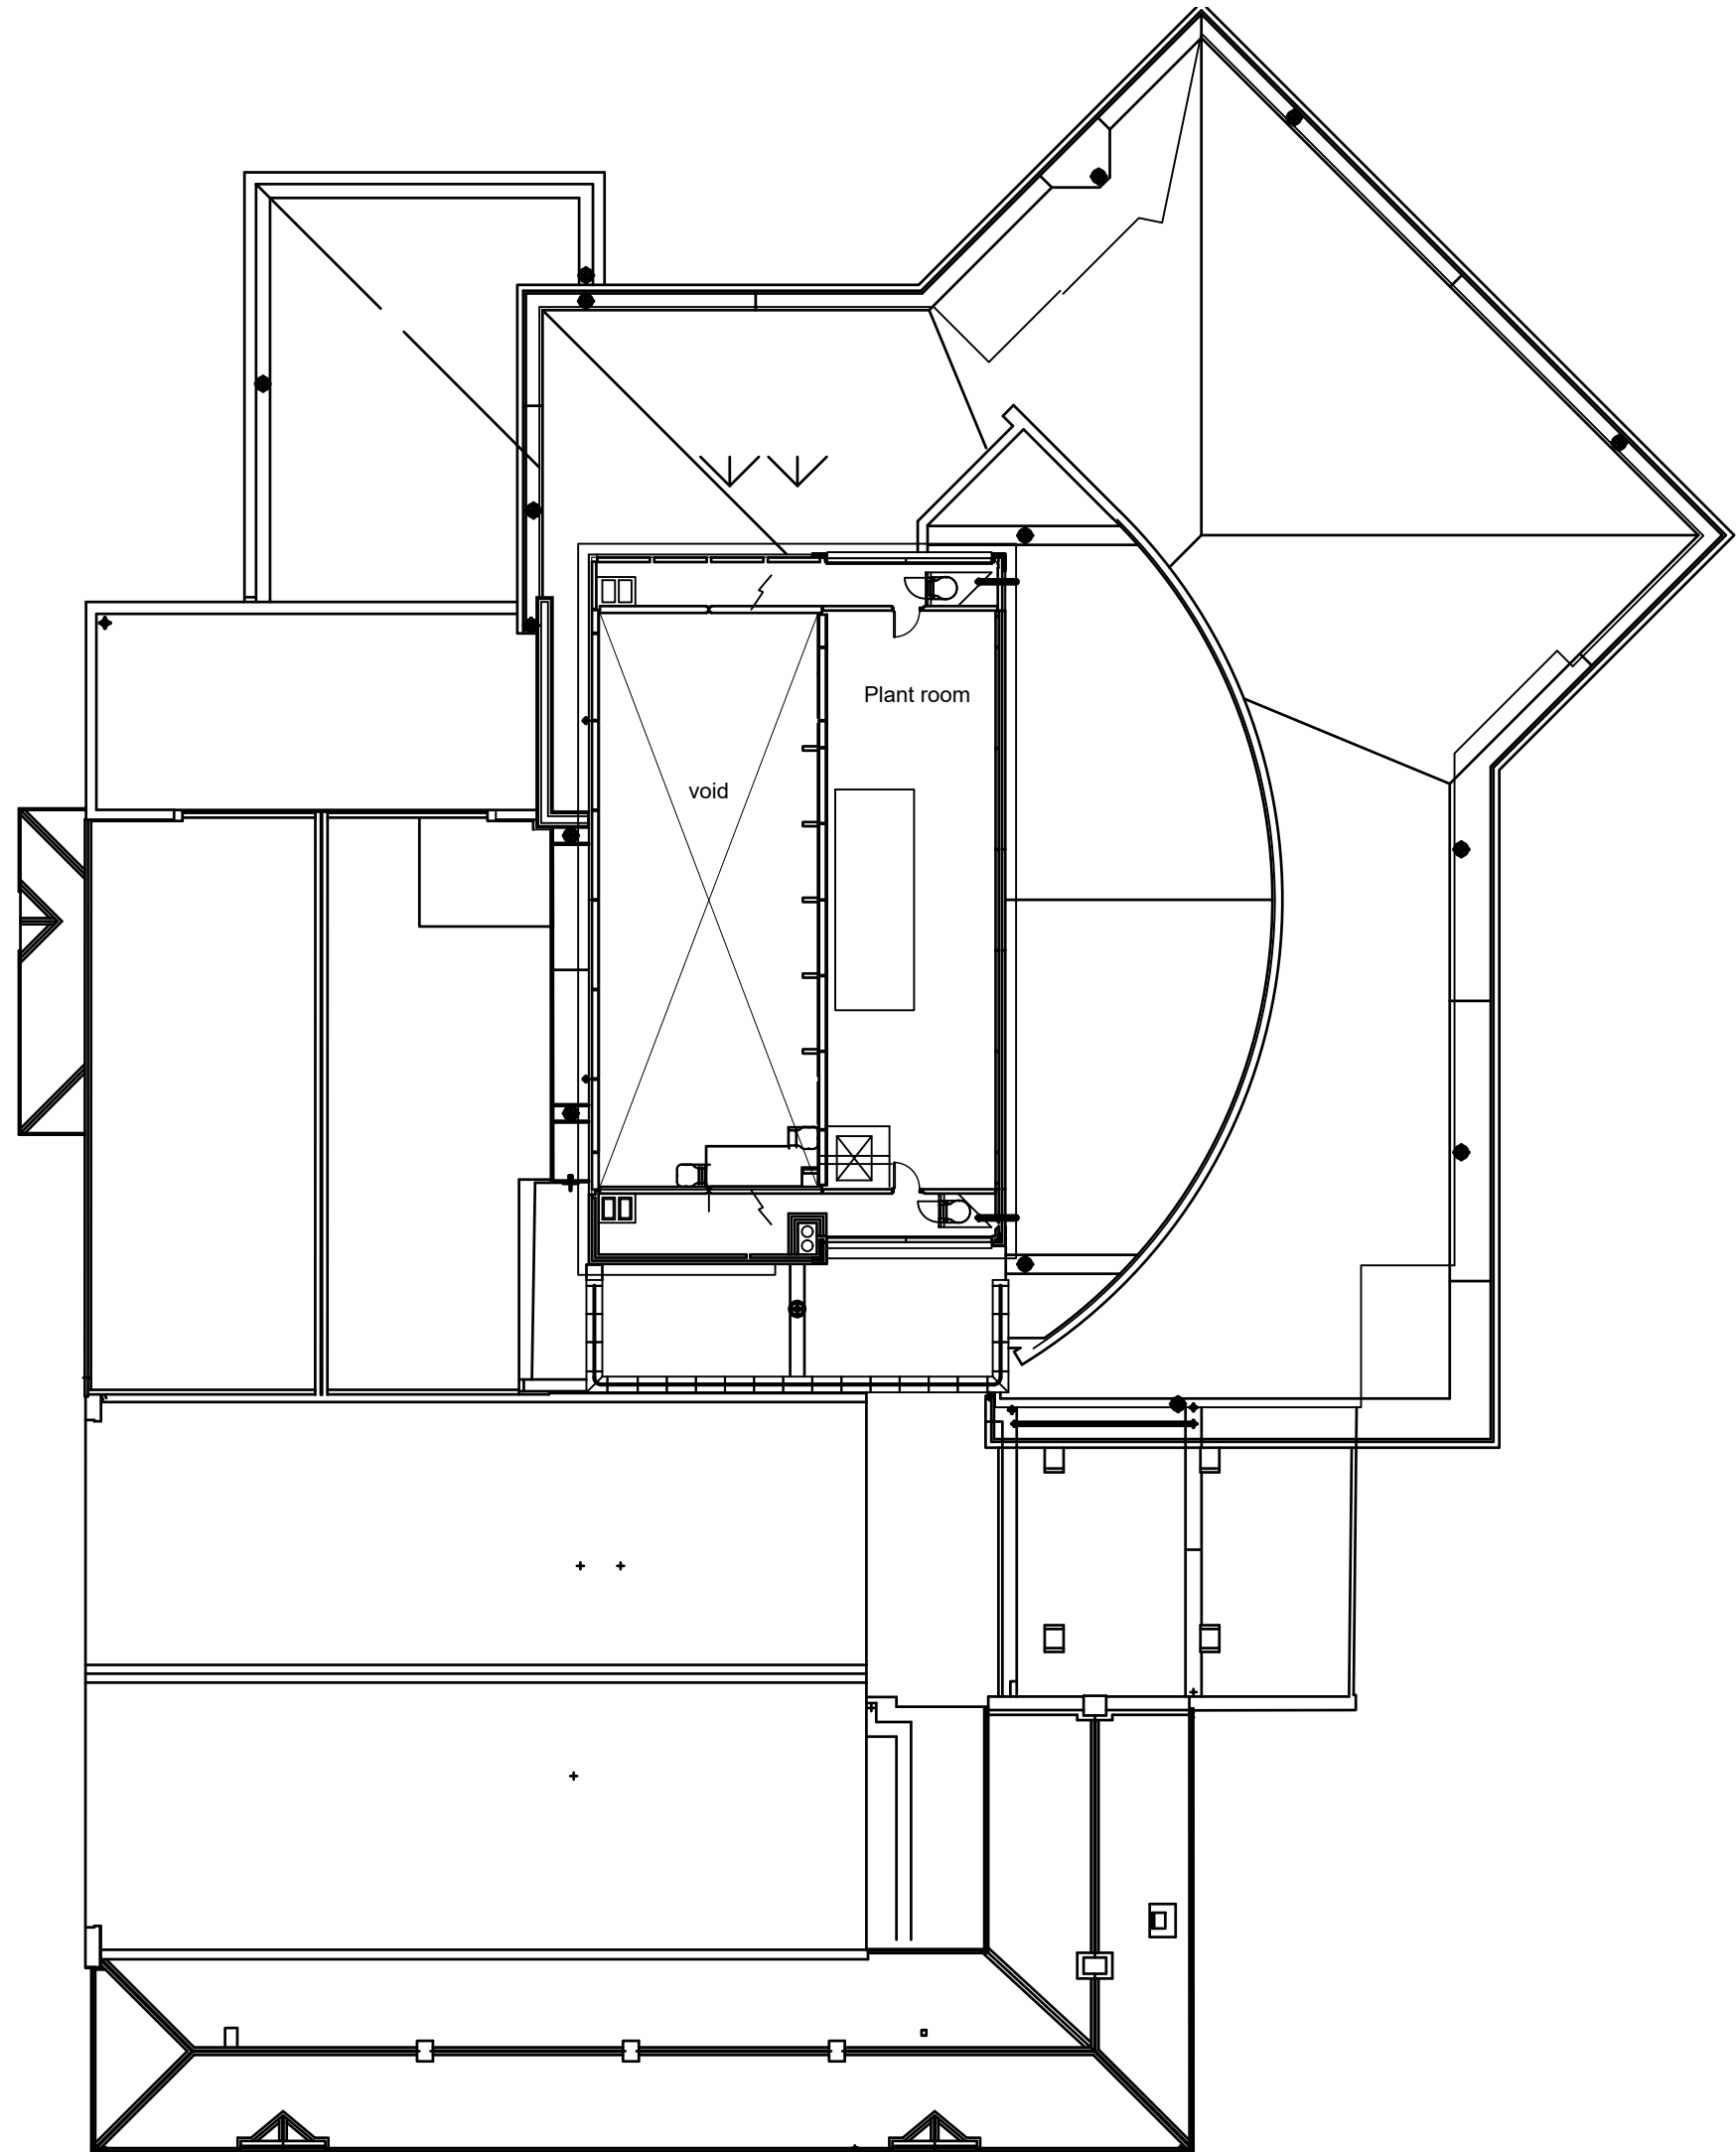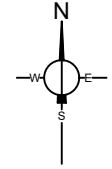

THIRD FLOOR PLAN



GENERAL LAYOUT PLAN

Rev	date	details	A3 sheet
Status			AS BUILT
<p>● all dimensions to be checked on site ● do not scale from drawings</p>			
Property Services West Lothian Civic Centre Howden South Road, Livingston EH54 6FF			
Project HOWDEN PARK CENTRE HOWDEN PARK LIVINGSTON			
Drawing THIRD FLOOR PLAN GENERAL PLAN			
date	JULY'22	scale(s)	1:250
project no.	***	drawn	WMC
		check	**
		Rev	-

OS Plan reproduced from Ordnance Survey mapping with the permission of the controller of Her Majesty's Stationery Office. Crown Copyright. Unauthorised reproduction infringes Crown copyright and may lead to prosecution or civil proceedings. West Lothian Council copyright license LA9002.



Location Plan

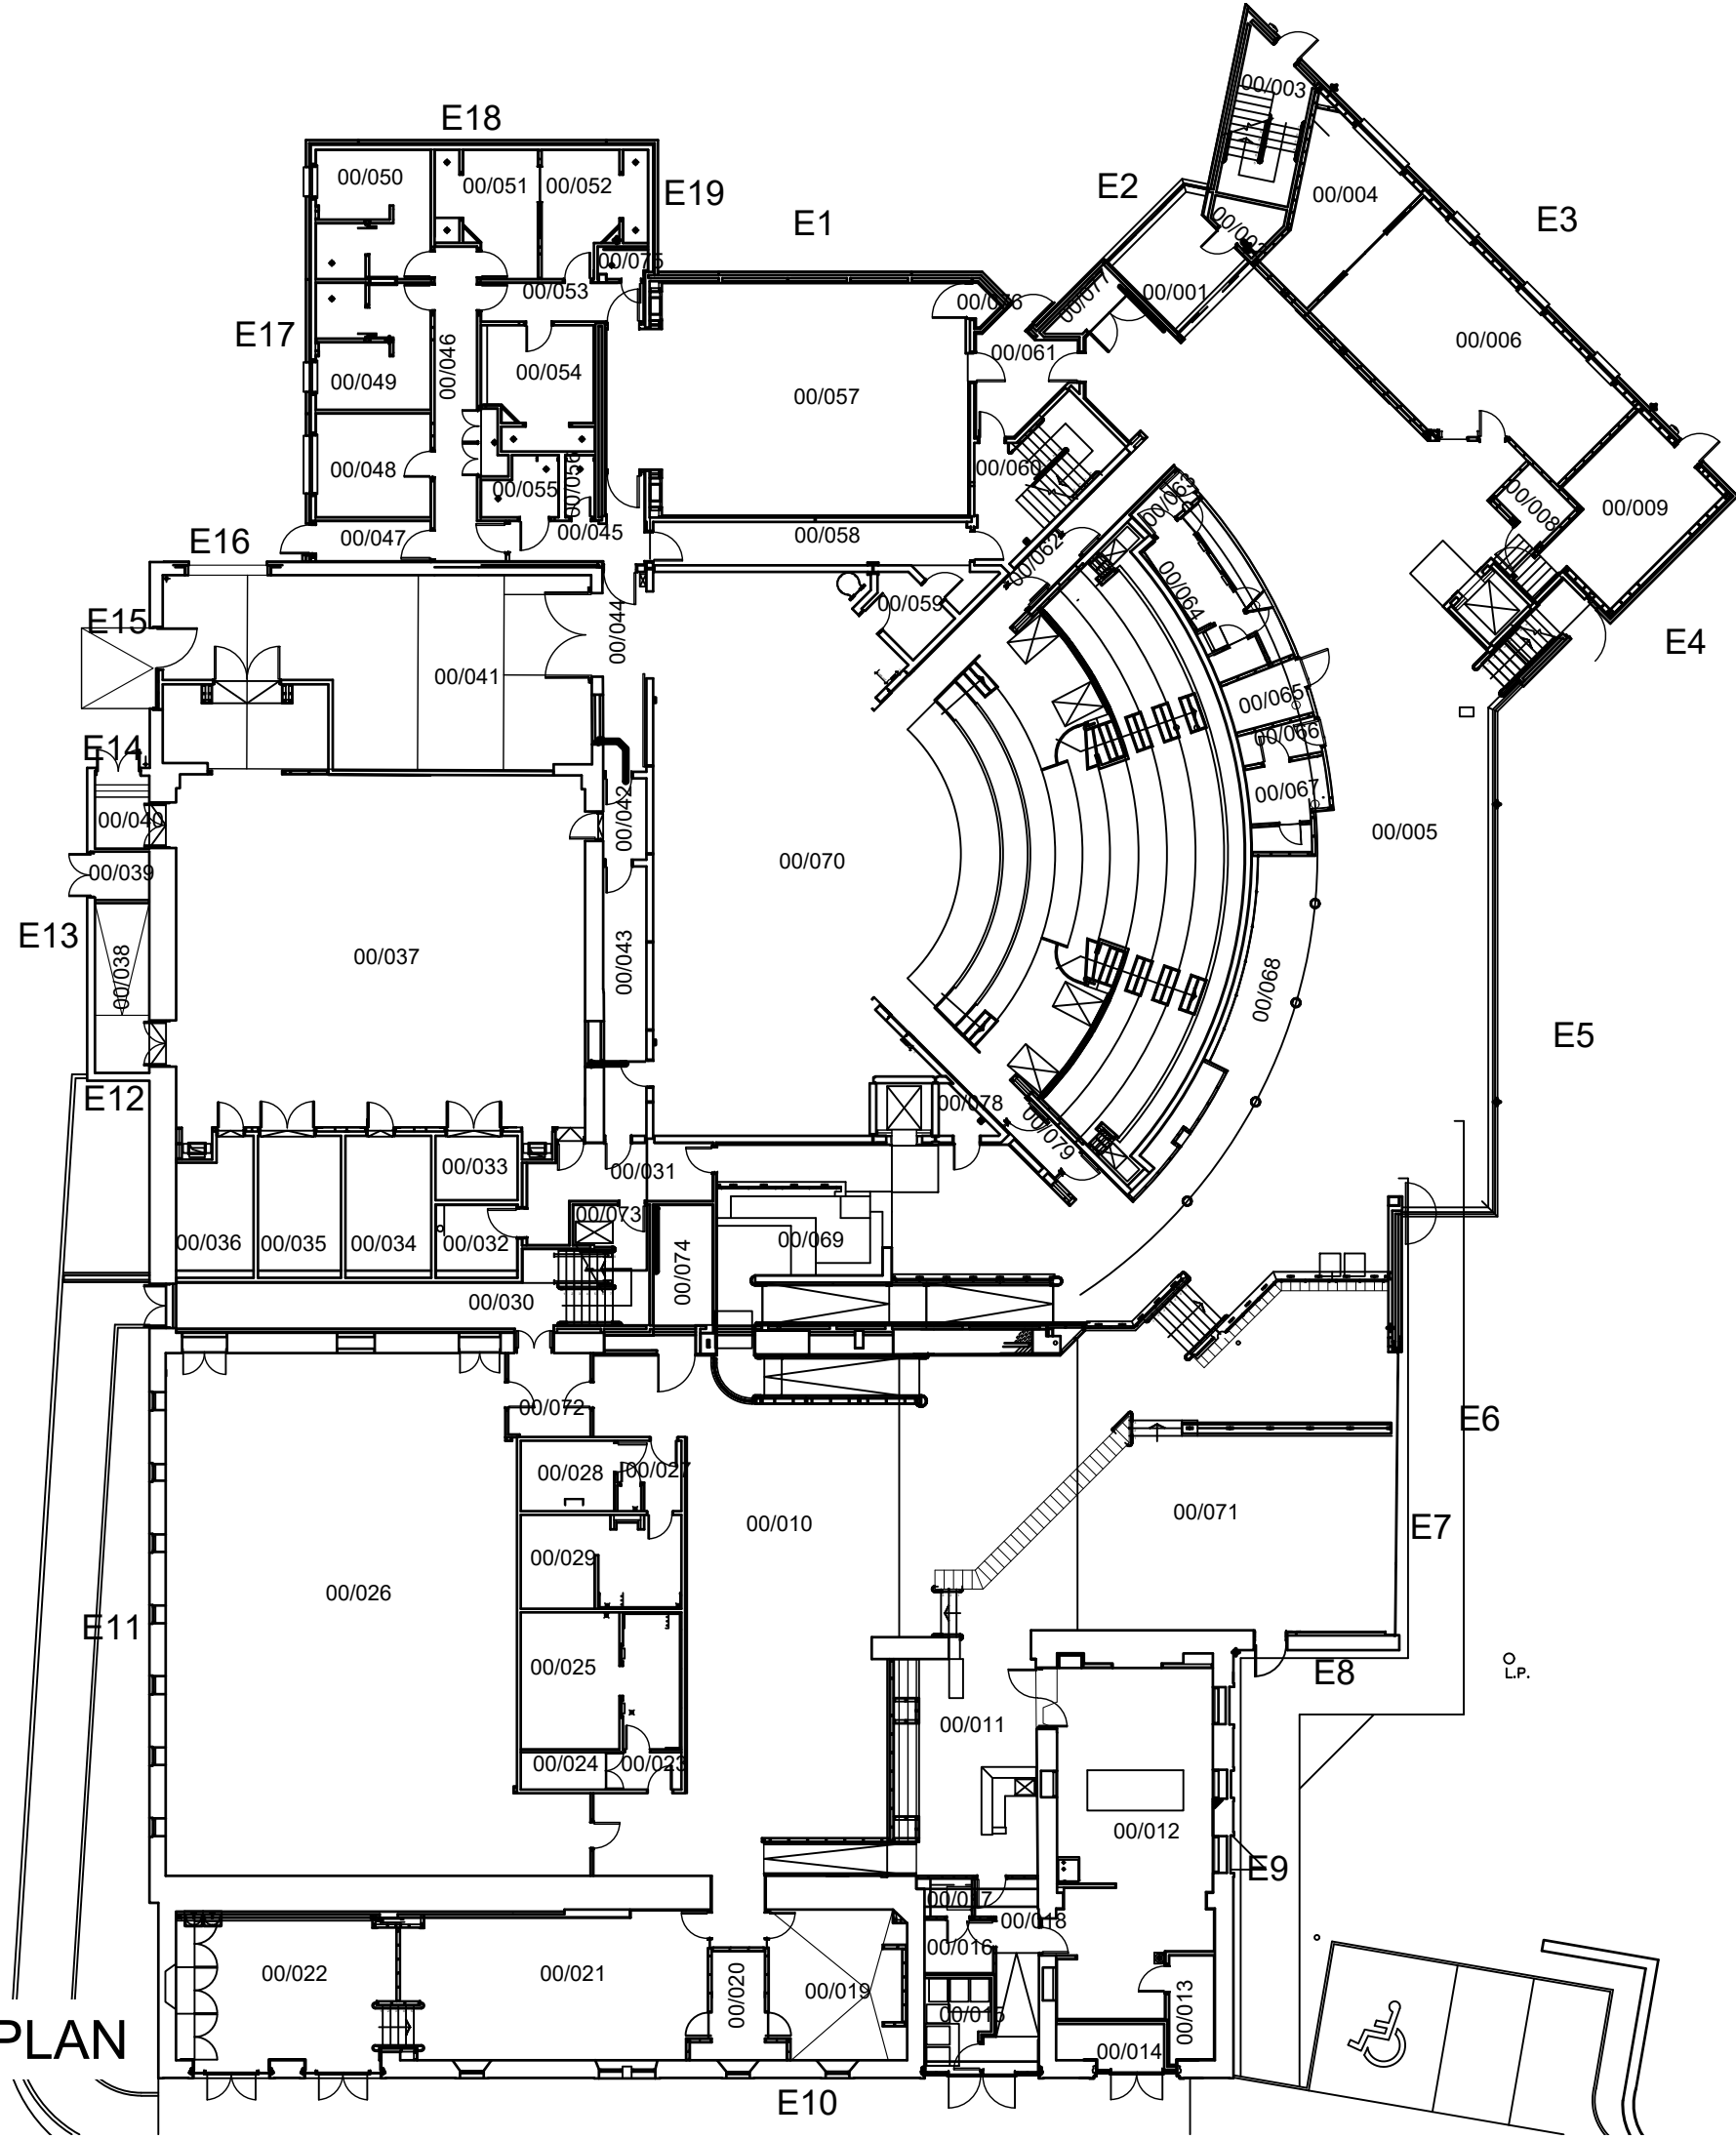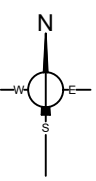

GROUND FLOOR PLAN



ASSET LAYOUT PLAN

Rev	date	details	A3 sheet
Status			AS BUILT
● all dimensions to be checked on site ● do not scale from drawings			
Property Services West Lothian Civic Centre Howden South Road, Livingston EH54 6FF			
Project HOWDEN PARK CENTRE HOWDEN PARK LIVINGSTON			
Drawing GROUND FLOOR PLAN ASSET PLAN			
date	JULY'22	scale(s)	1:250
project no.	***	drawing no.	***
drawn	WMC	check	**
Rev	-		

OS Plan reproduced from Ordnance Survey mapping with the permission of the controller of Her Majesty's Stationery Office. Crown Copyright. Unauthorised reproduction infringes Crown copyright and may lead to prosecution or civil proceedings. West Lothian Council copyright license LA9002.



Location Plan

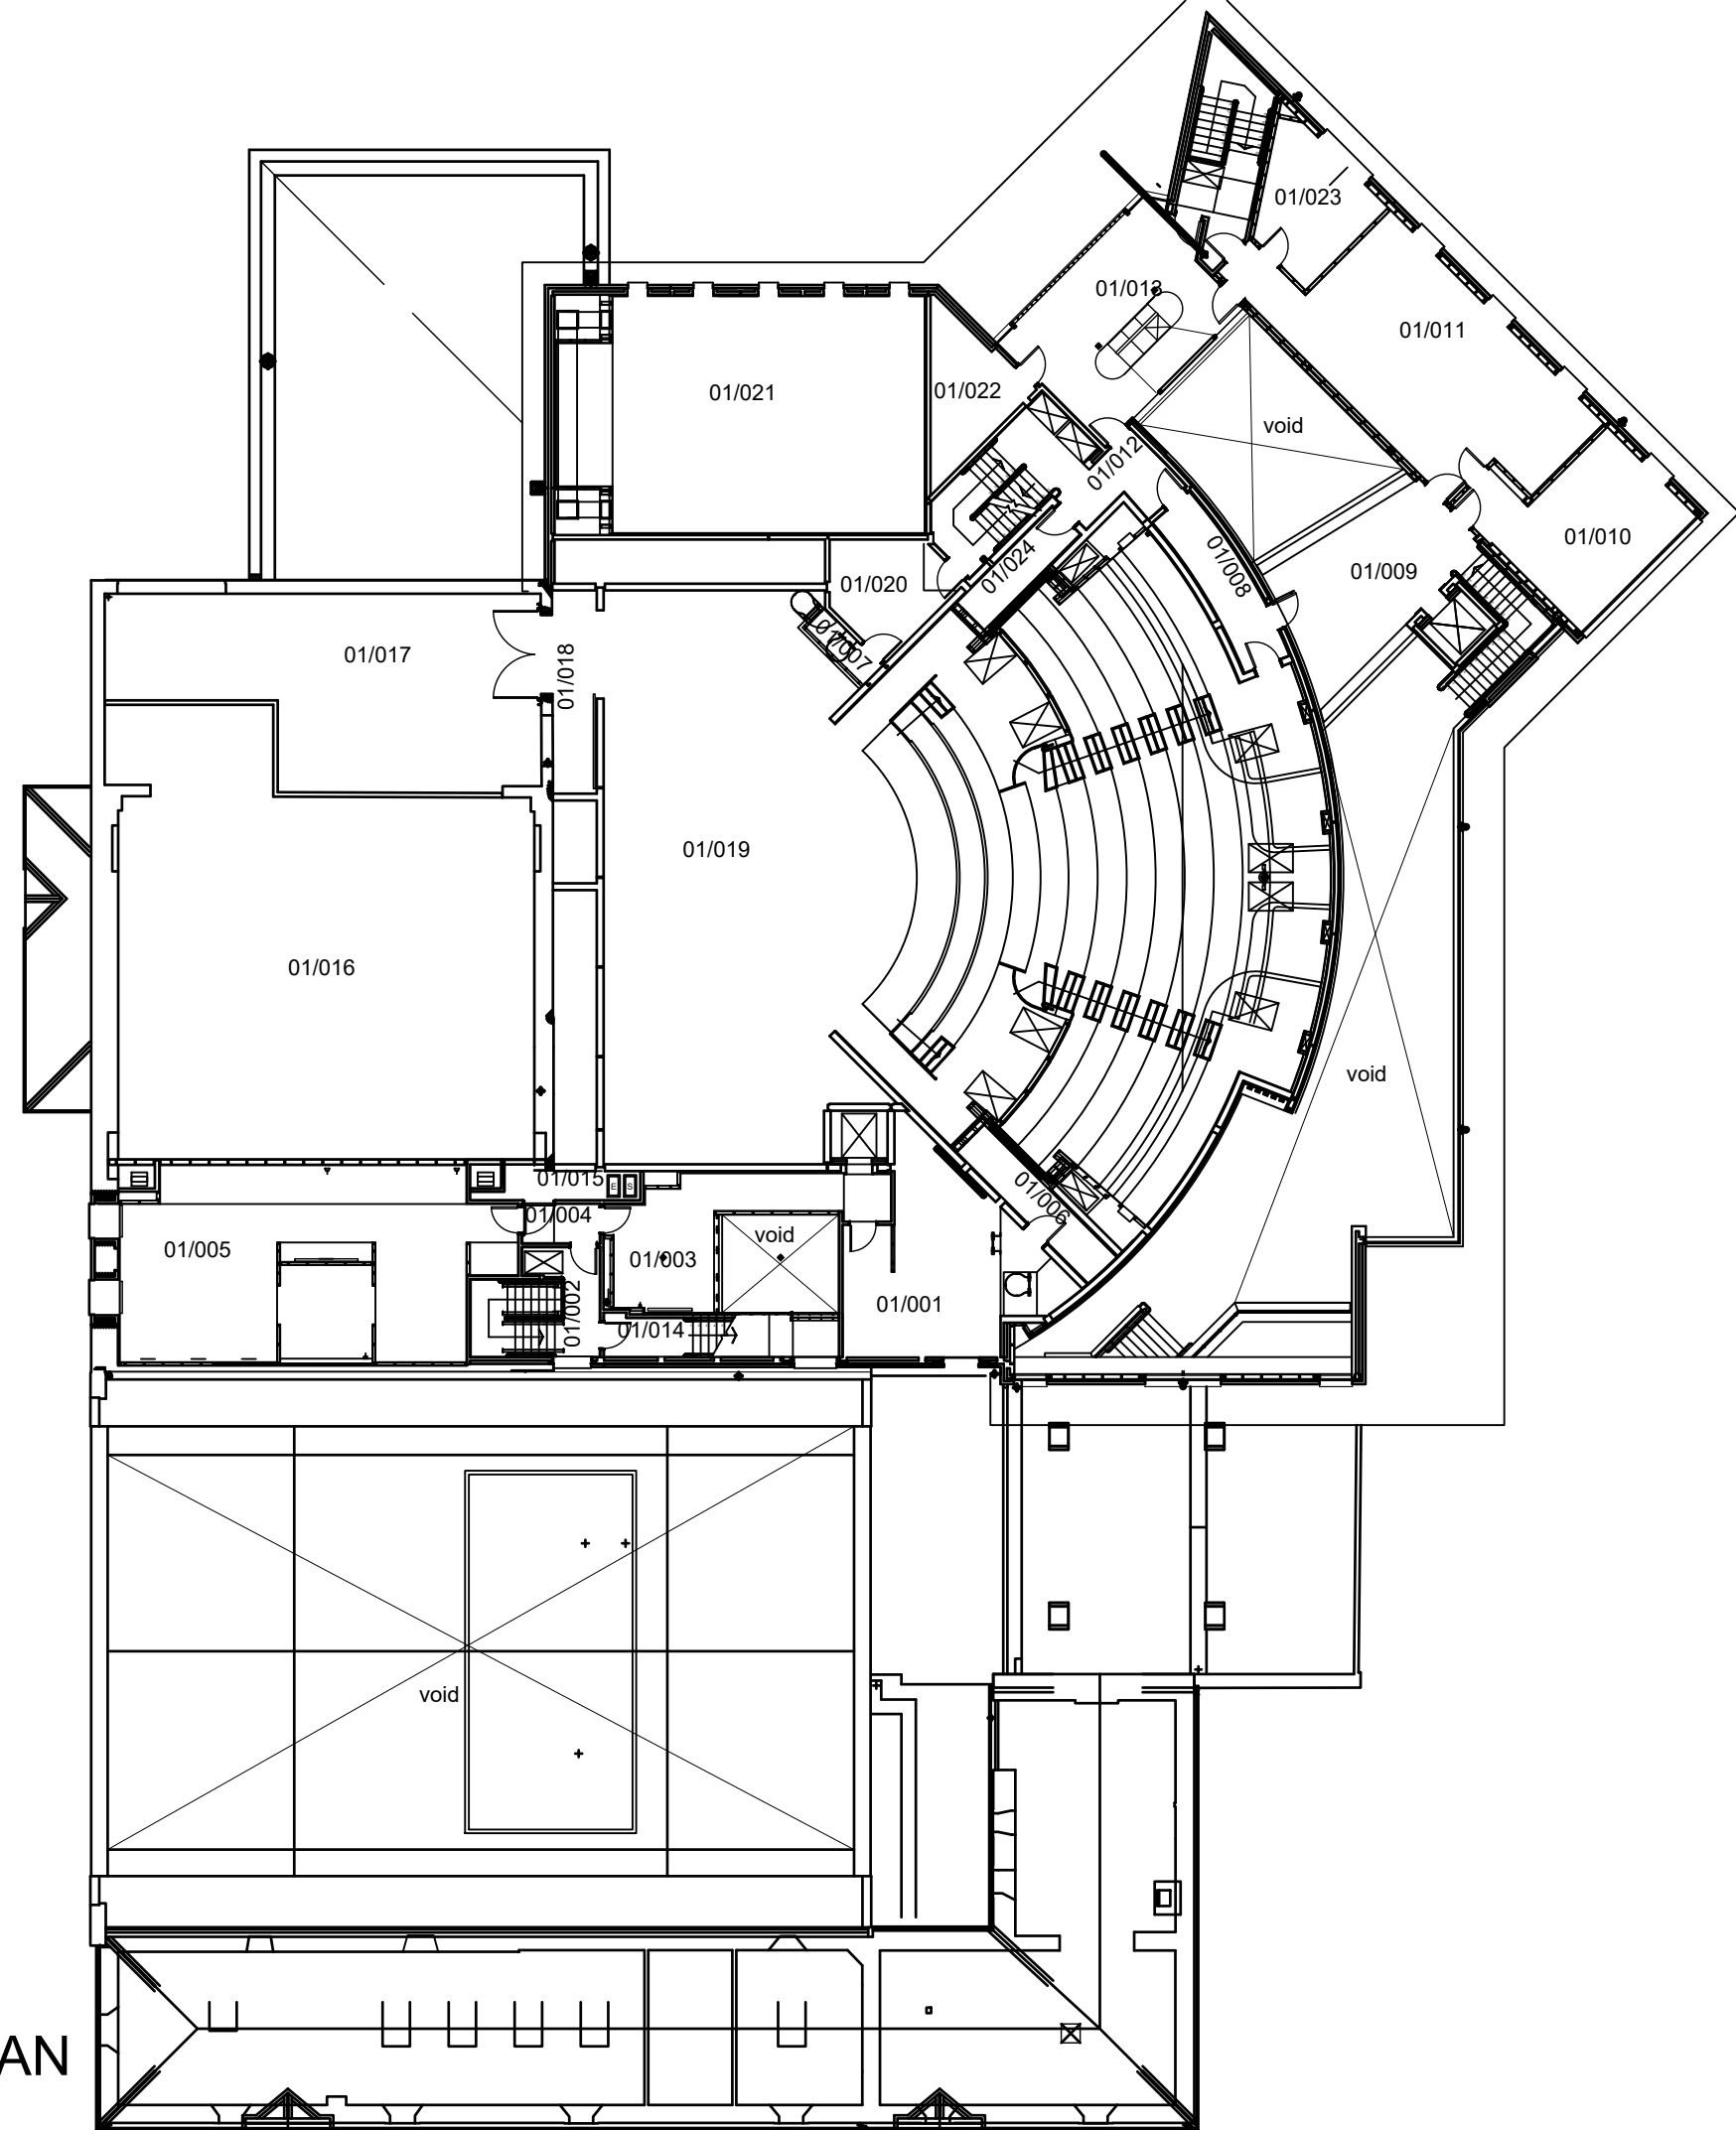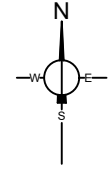

FIRST FLOOR PLAN



ASSET LAYOUT PLAN

Rev	date	details	A3 sheet
Status			AS BUILT
<p>● all dimensions to be checked on site ● do not scale from drawings</p>			
Property Services West Lothian Civic Centre Howden South Road, Livingston EH54 6FF			
Project HOWDEN PARK CENTRE HOWDEN PARK LIVINGSTON			
Drawing FIRST FLOOR PLAN ASSET PLAN			
date	JULY'22	scale(s)	1:250
project no.	***	drawing no.	***
drawn	WMC	check	**
Rev	-		

OS Plan reproduced from Ordnance Survey mapping with the permission of the controller of Her Majesty's Stationery Office. Crown Copyright. Unauthorised reproduction infringes Crown copyright and may lead to prosecution or civil proceedings. West Lothian Council copyright license LA9002.



Location Plan

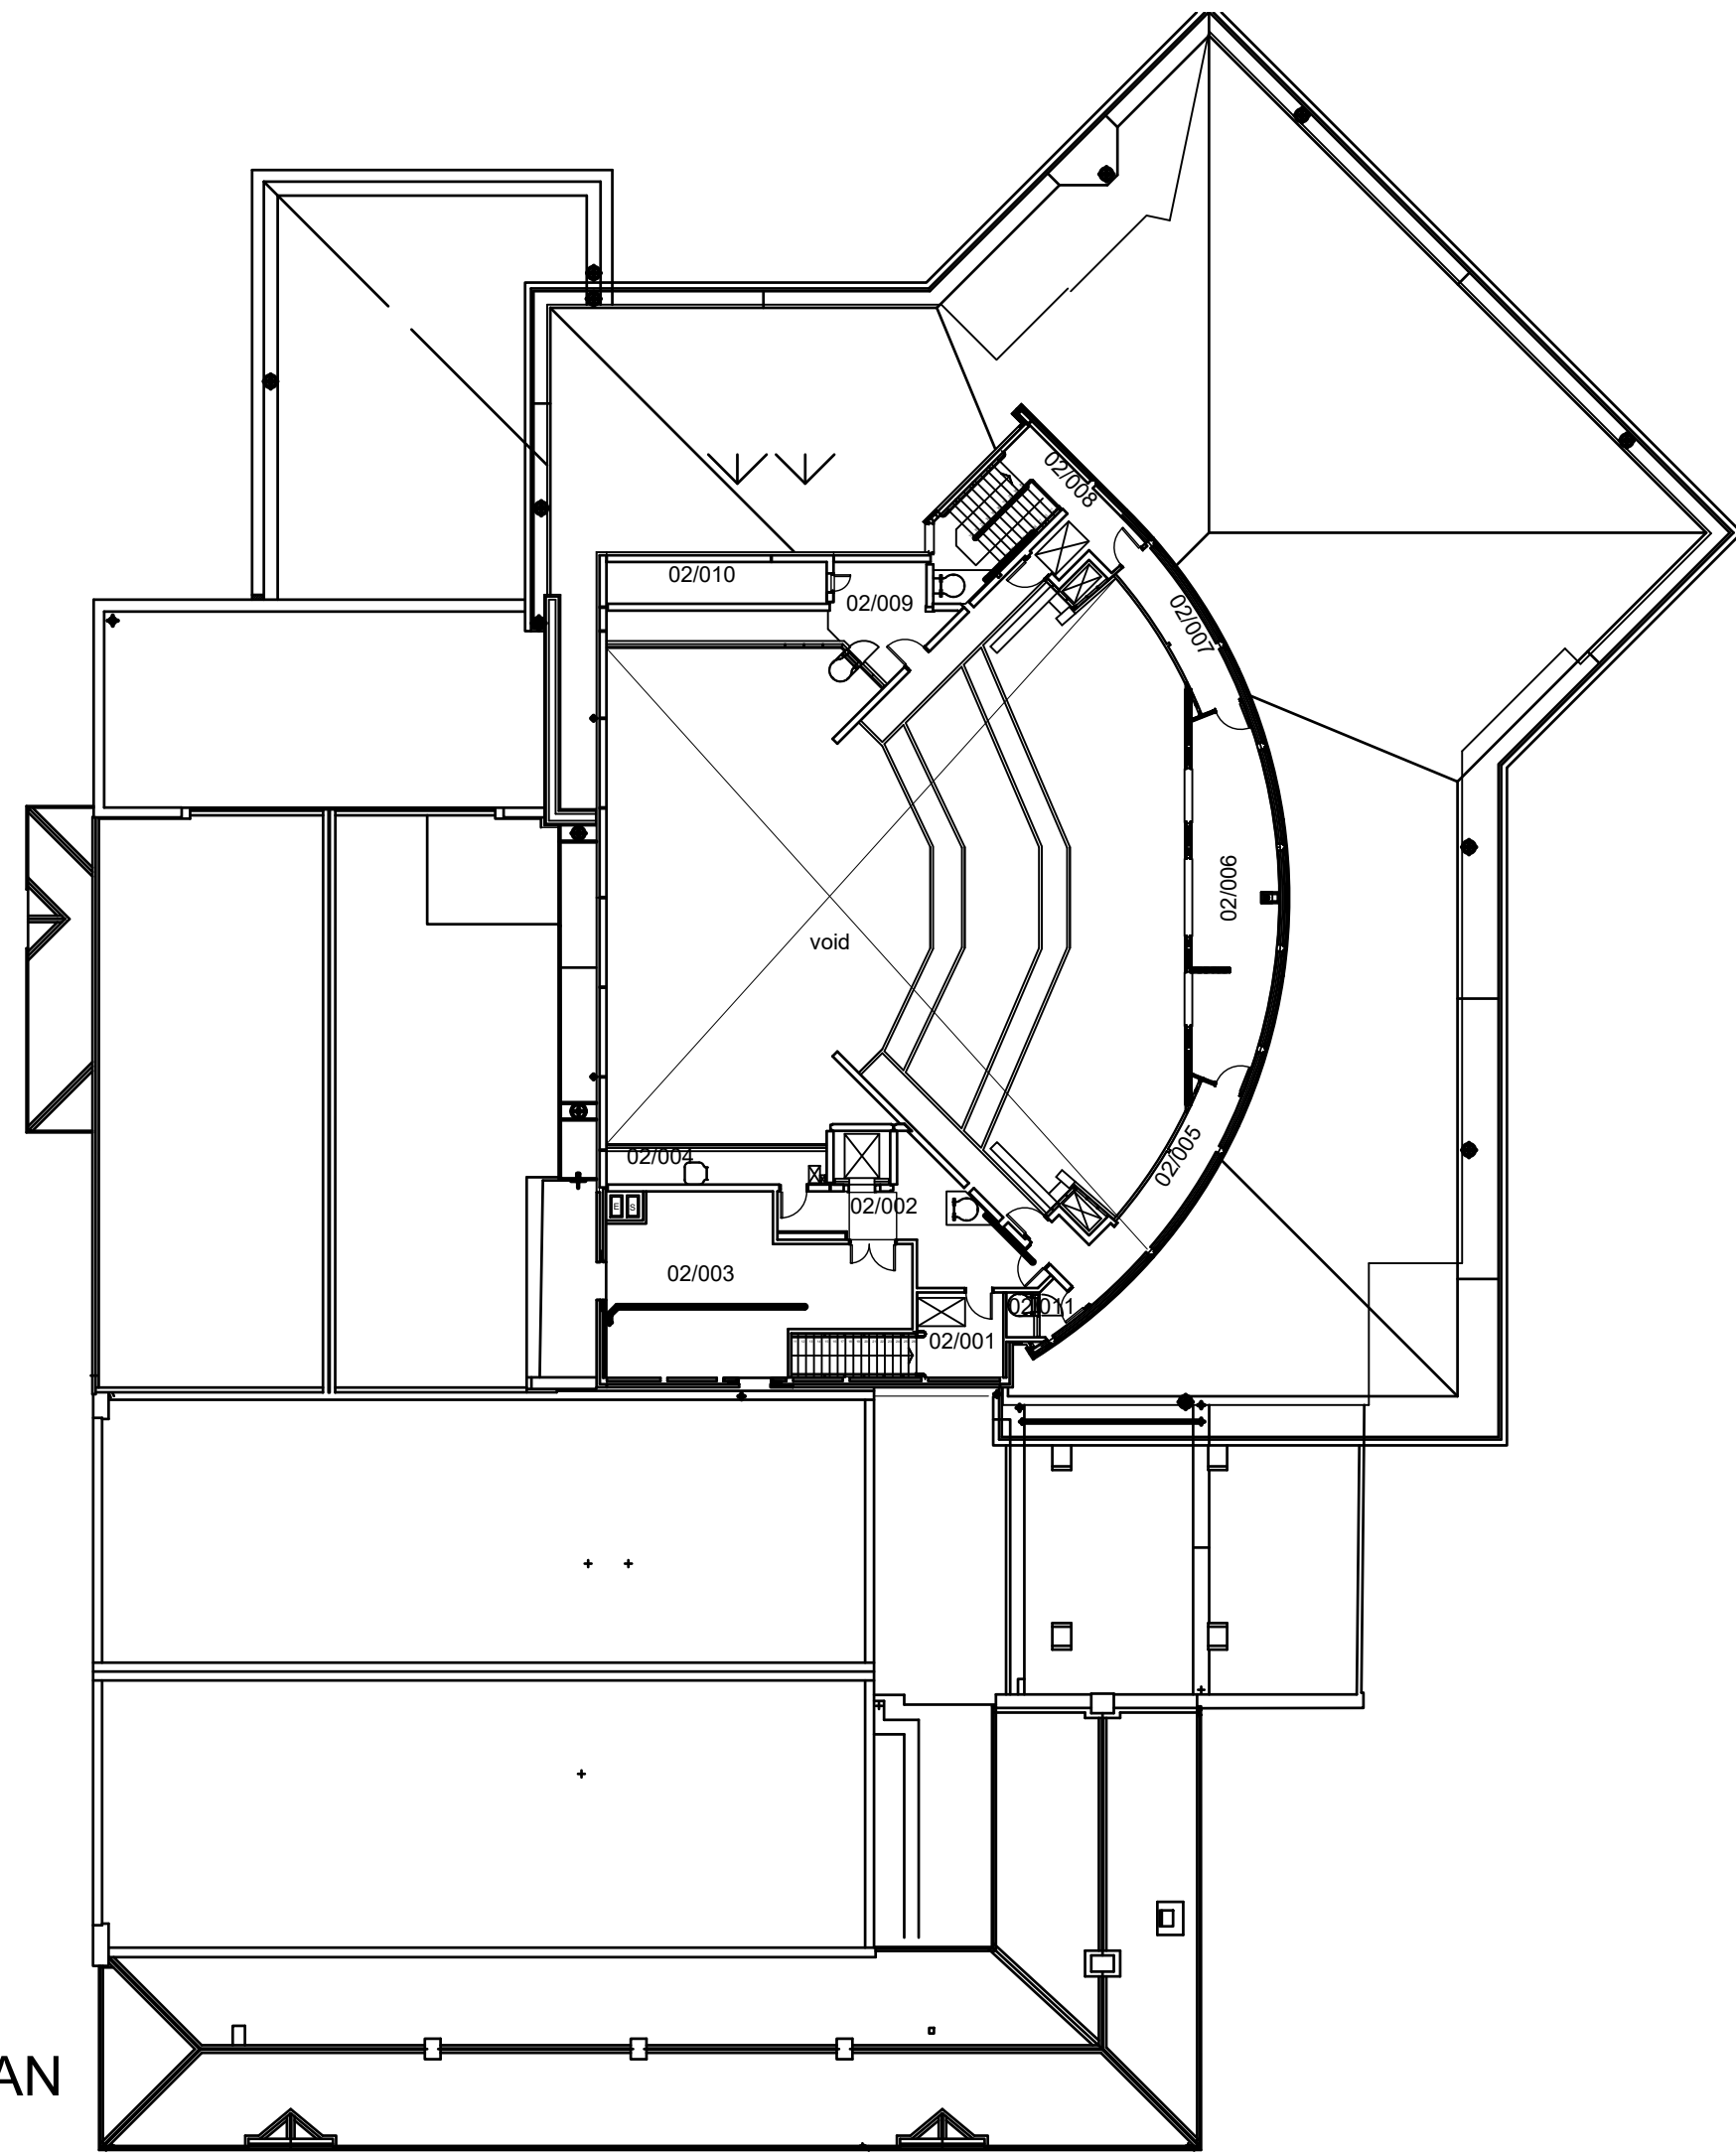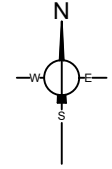

SECOND FLOOR PLAN



ASSET LAYOUT PLAN

Rev	date	details	A3 sheet
Status			AS BUILT
<p>● all dimensions to be checked on site ● do not scale from drawings</p>			
Property Services West Lothian Civic Centre Howden South Road, Livingston EH54 6FF			
Project HOWDEN PARK CENTRE HOWDEN PARK LIVINGSTON			
Drawing SECOND FLOOR PLAN ASSET PLAN			
date	JULY'22	scale(s)	1:250
project no.	***	drawing no.	***
drawn	WMC	check	**
Rev	-		

OS Plan reproduced from Ordnance Survey mapping with the permission of the controller of Her Majesty's Stationery Office. Crown Copyright. Unauthorised reproduction infringes Crown copyright and may lead to prosecution or civil proceedings. West Lothian Council copyright license LA9002.



Location Plan

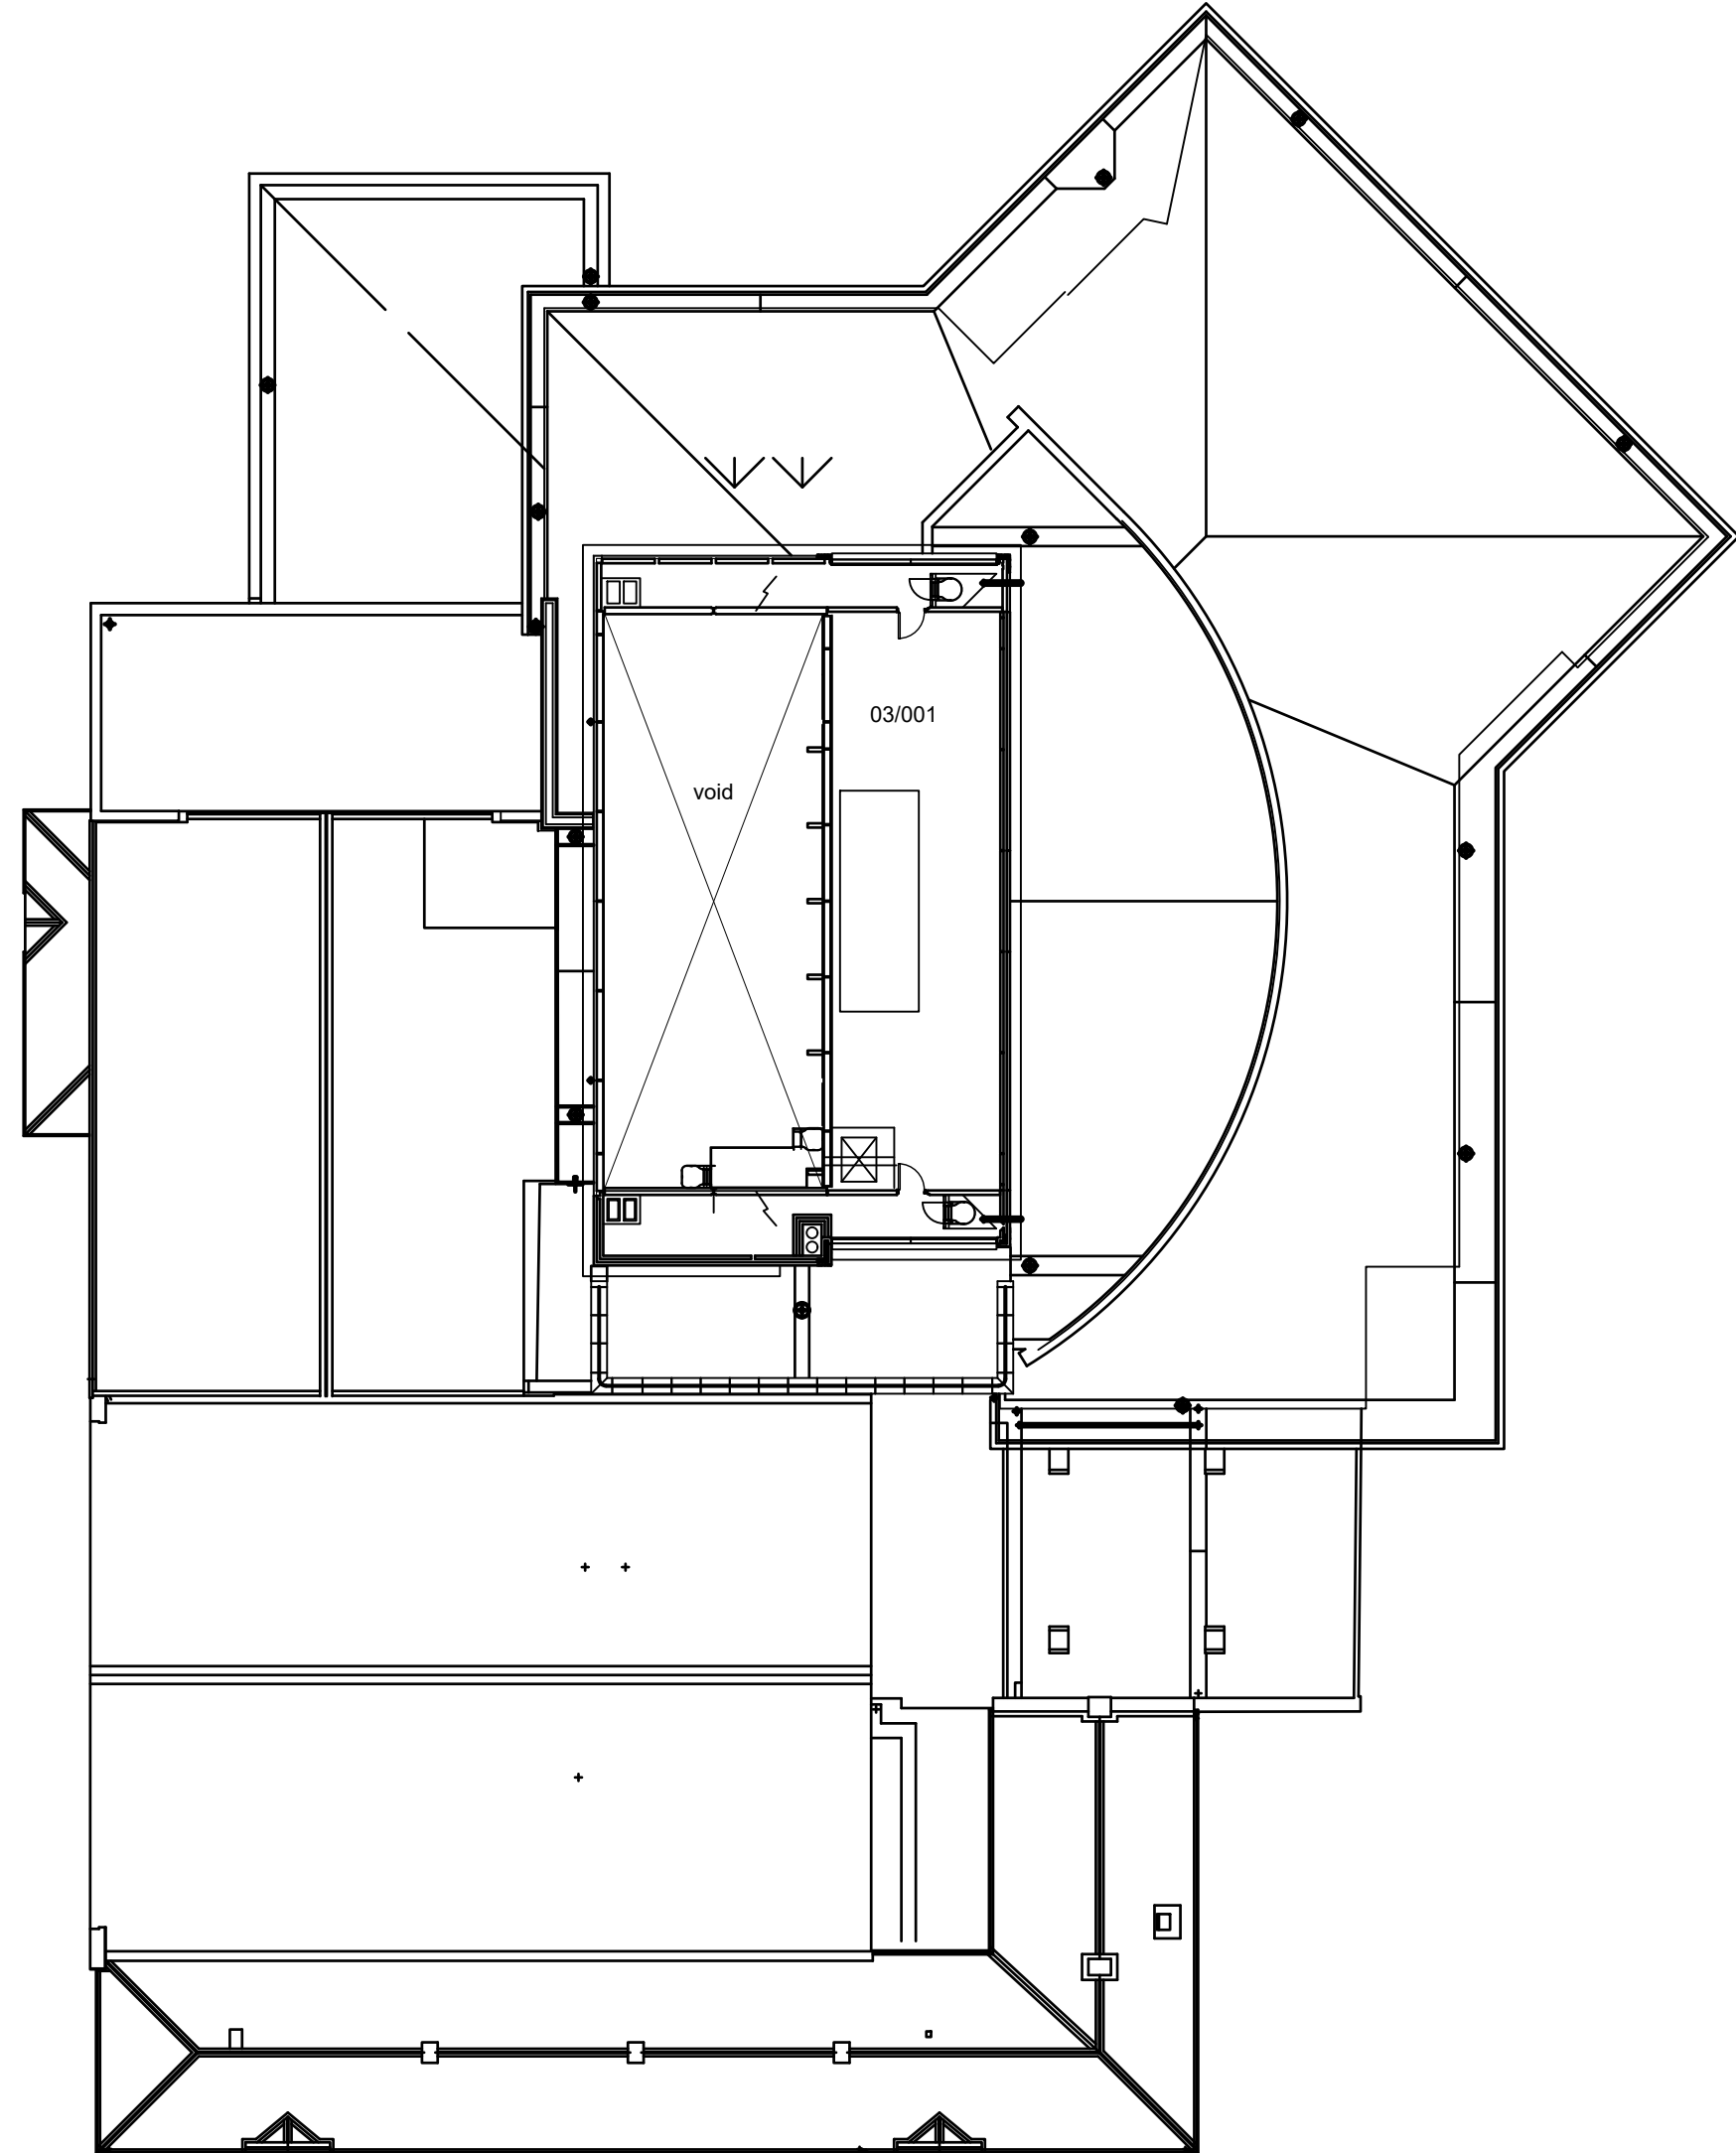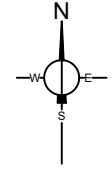



THIRD FLOOR PLAN

ASSET LAYOUT PLAN

Rev	date	details	A3 sheet
Status		AS BUILT	
<p>● all dimensions to be checked on site ● do not scale from drawings</p>			
Property Services West Lothian Civic Centre Howden South Road, Livingston EH54 6FF			
Project HOWDEN PARK CENTRE HOWDEN PARK LIVINGSTON			
Drawing THIRD FLOOR PLAN ASSET PLAN			
date	JULY'22	scale(s)	1:250
drawn	WMC	check	**
project no.	***	drawing no.	***
Rev	-		



Location Plan

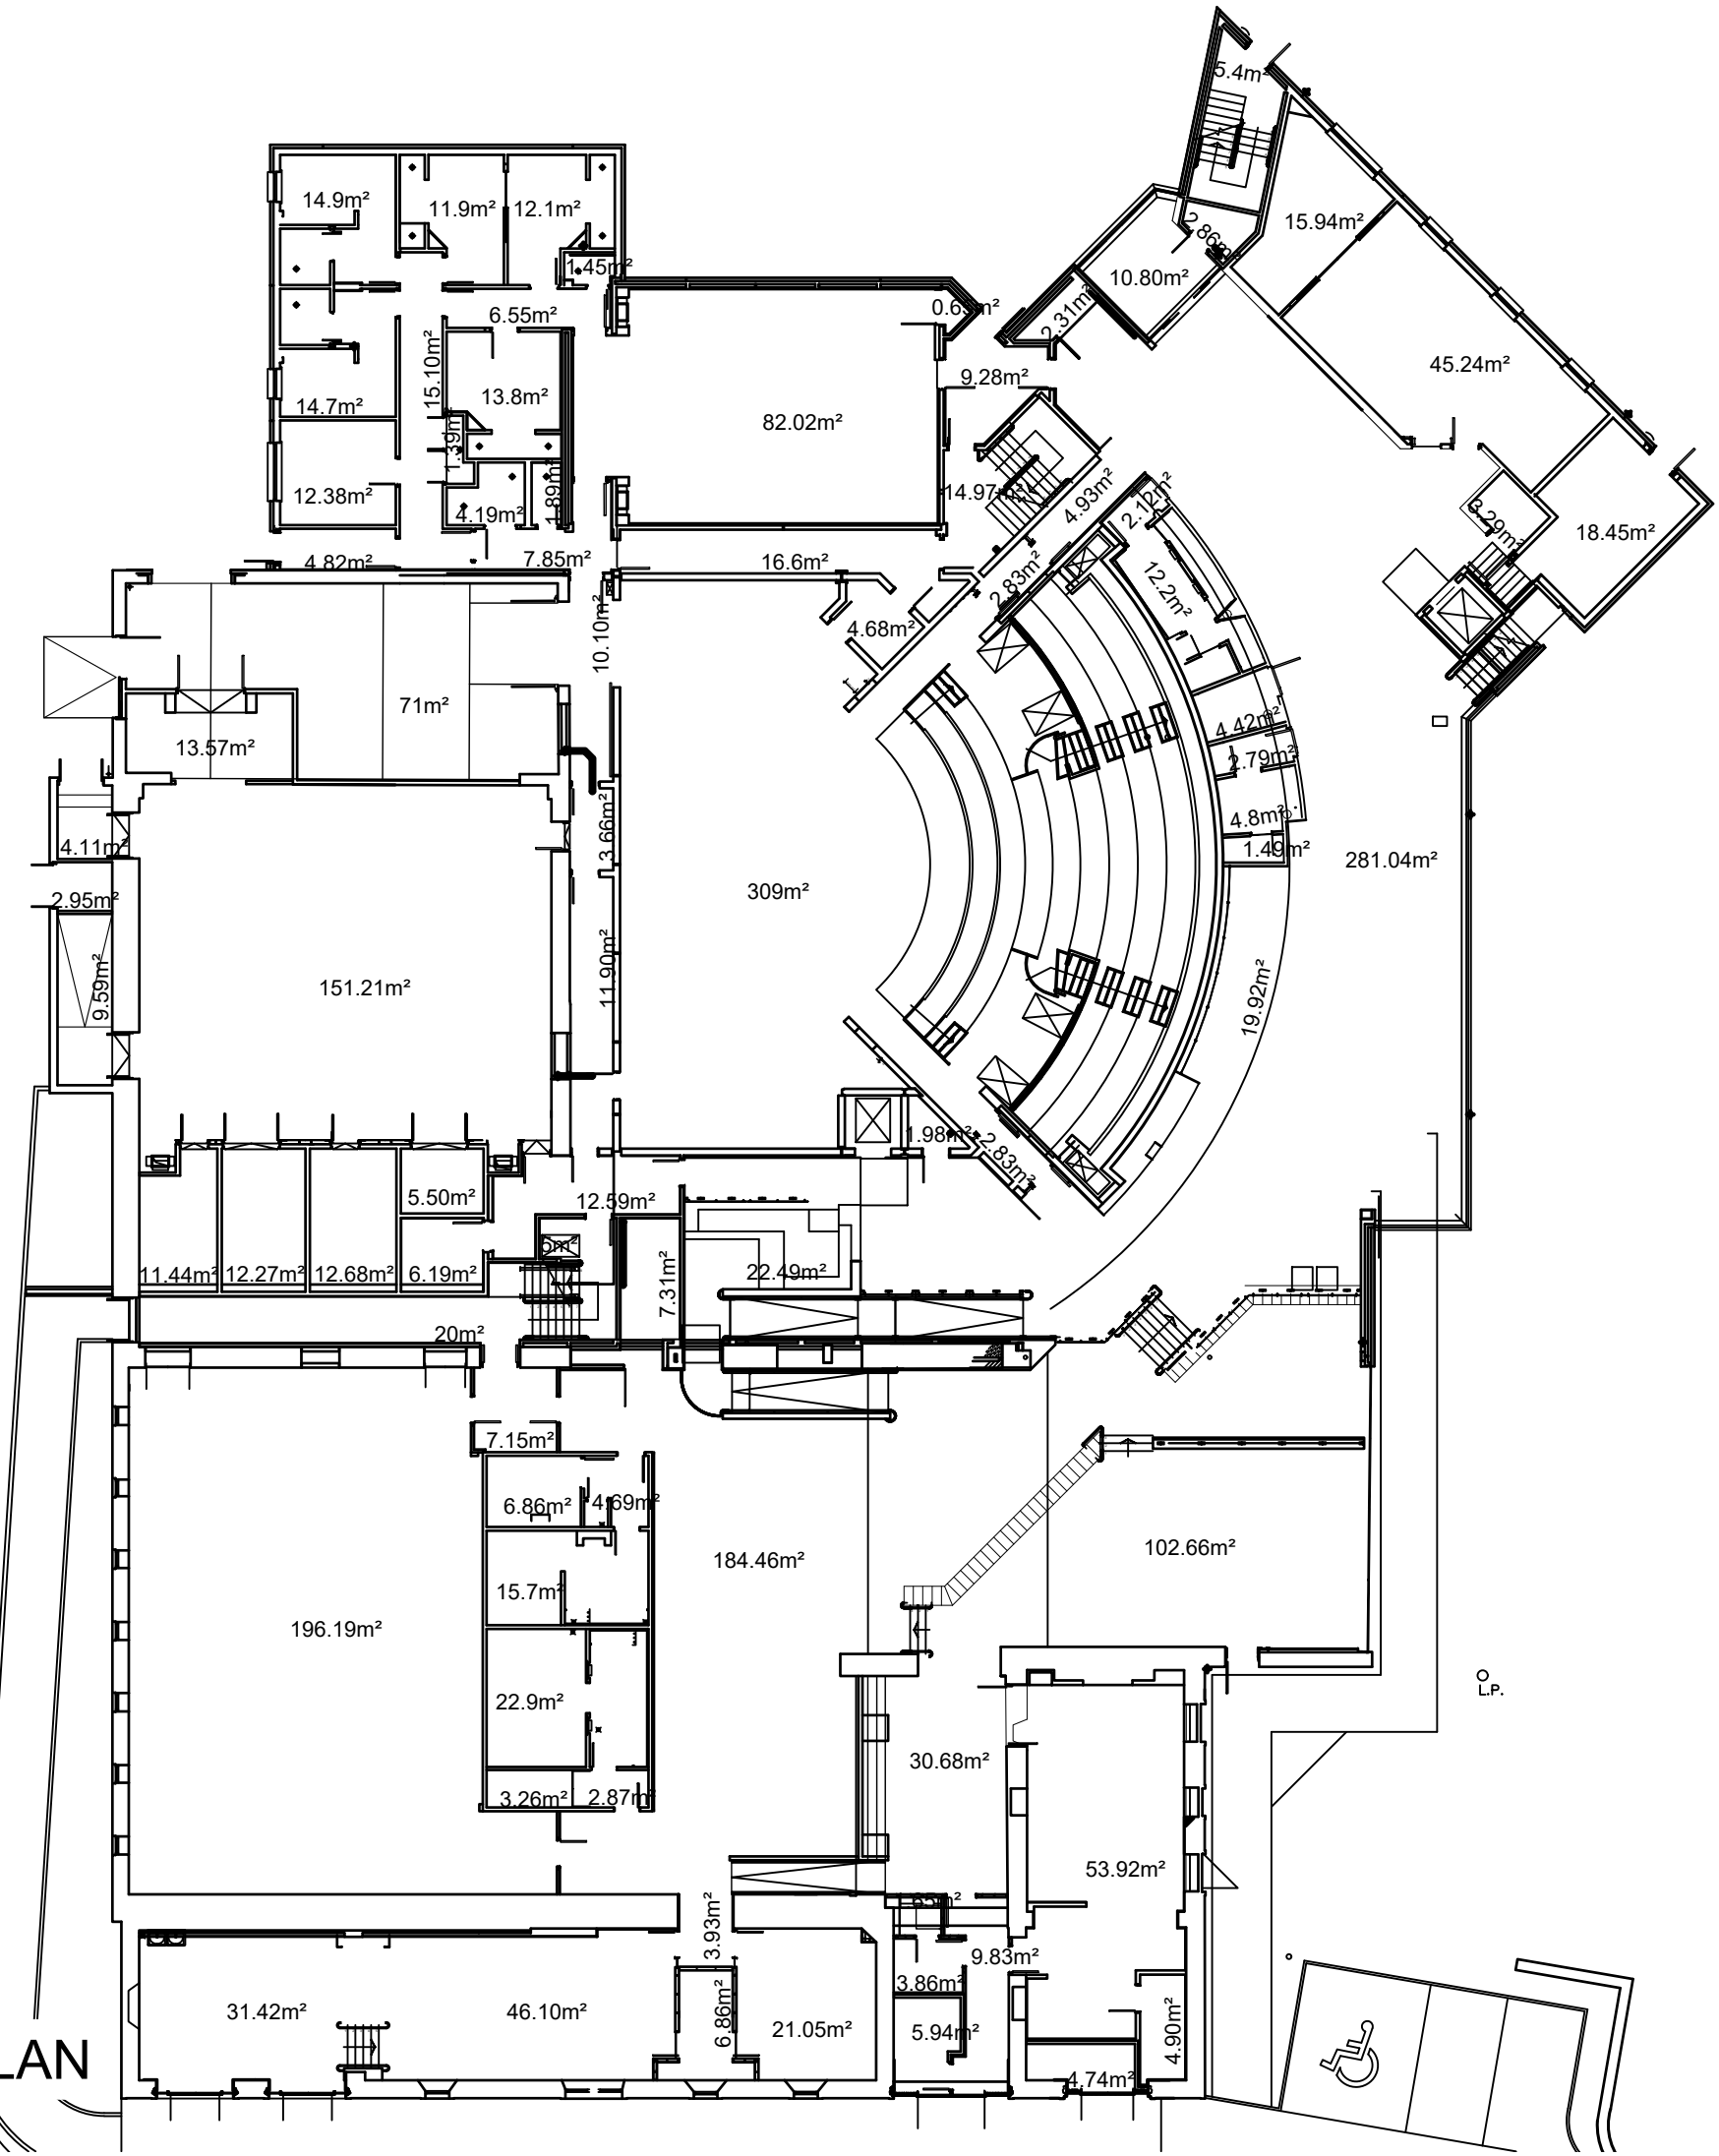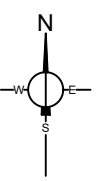

GROUND FLOOR PLAN
GIFA = 4701.6m²



AREA LAYOUT PLAN

Rev	date	details	A3 sheet
Status			AS BUILT
● all dimensions to be checked on site ● do not scale from drawings			
Property Services West Lothian Civic Centre Howden South Road, Livingston EH54 6FF			
Project HOWDEN PARK CENTRE HOWDEN PARK LIVINGSTON			
Drawing GROUND FLOOR PLAN AREA PLAN			
date	JULY'22	scale(s)	1:250
project no.	***	drawn	WMC
		check	**
		rev	-

OS Plan reproduced from Ordnance Survey mapping with the permission of the controller of Her Majesty's Stationery Office. Crown Copyright. Unauthorised reproduction infringes Crown copyright and may lead to prosecution or civil proceedings. West Lothian Council copyright license LA9020.



Location Plan

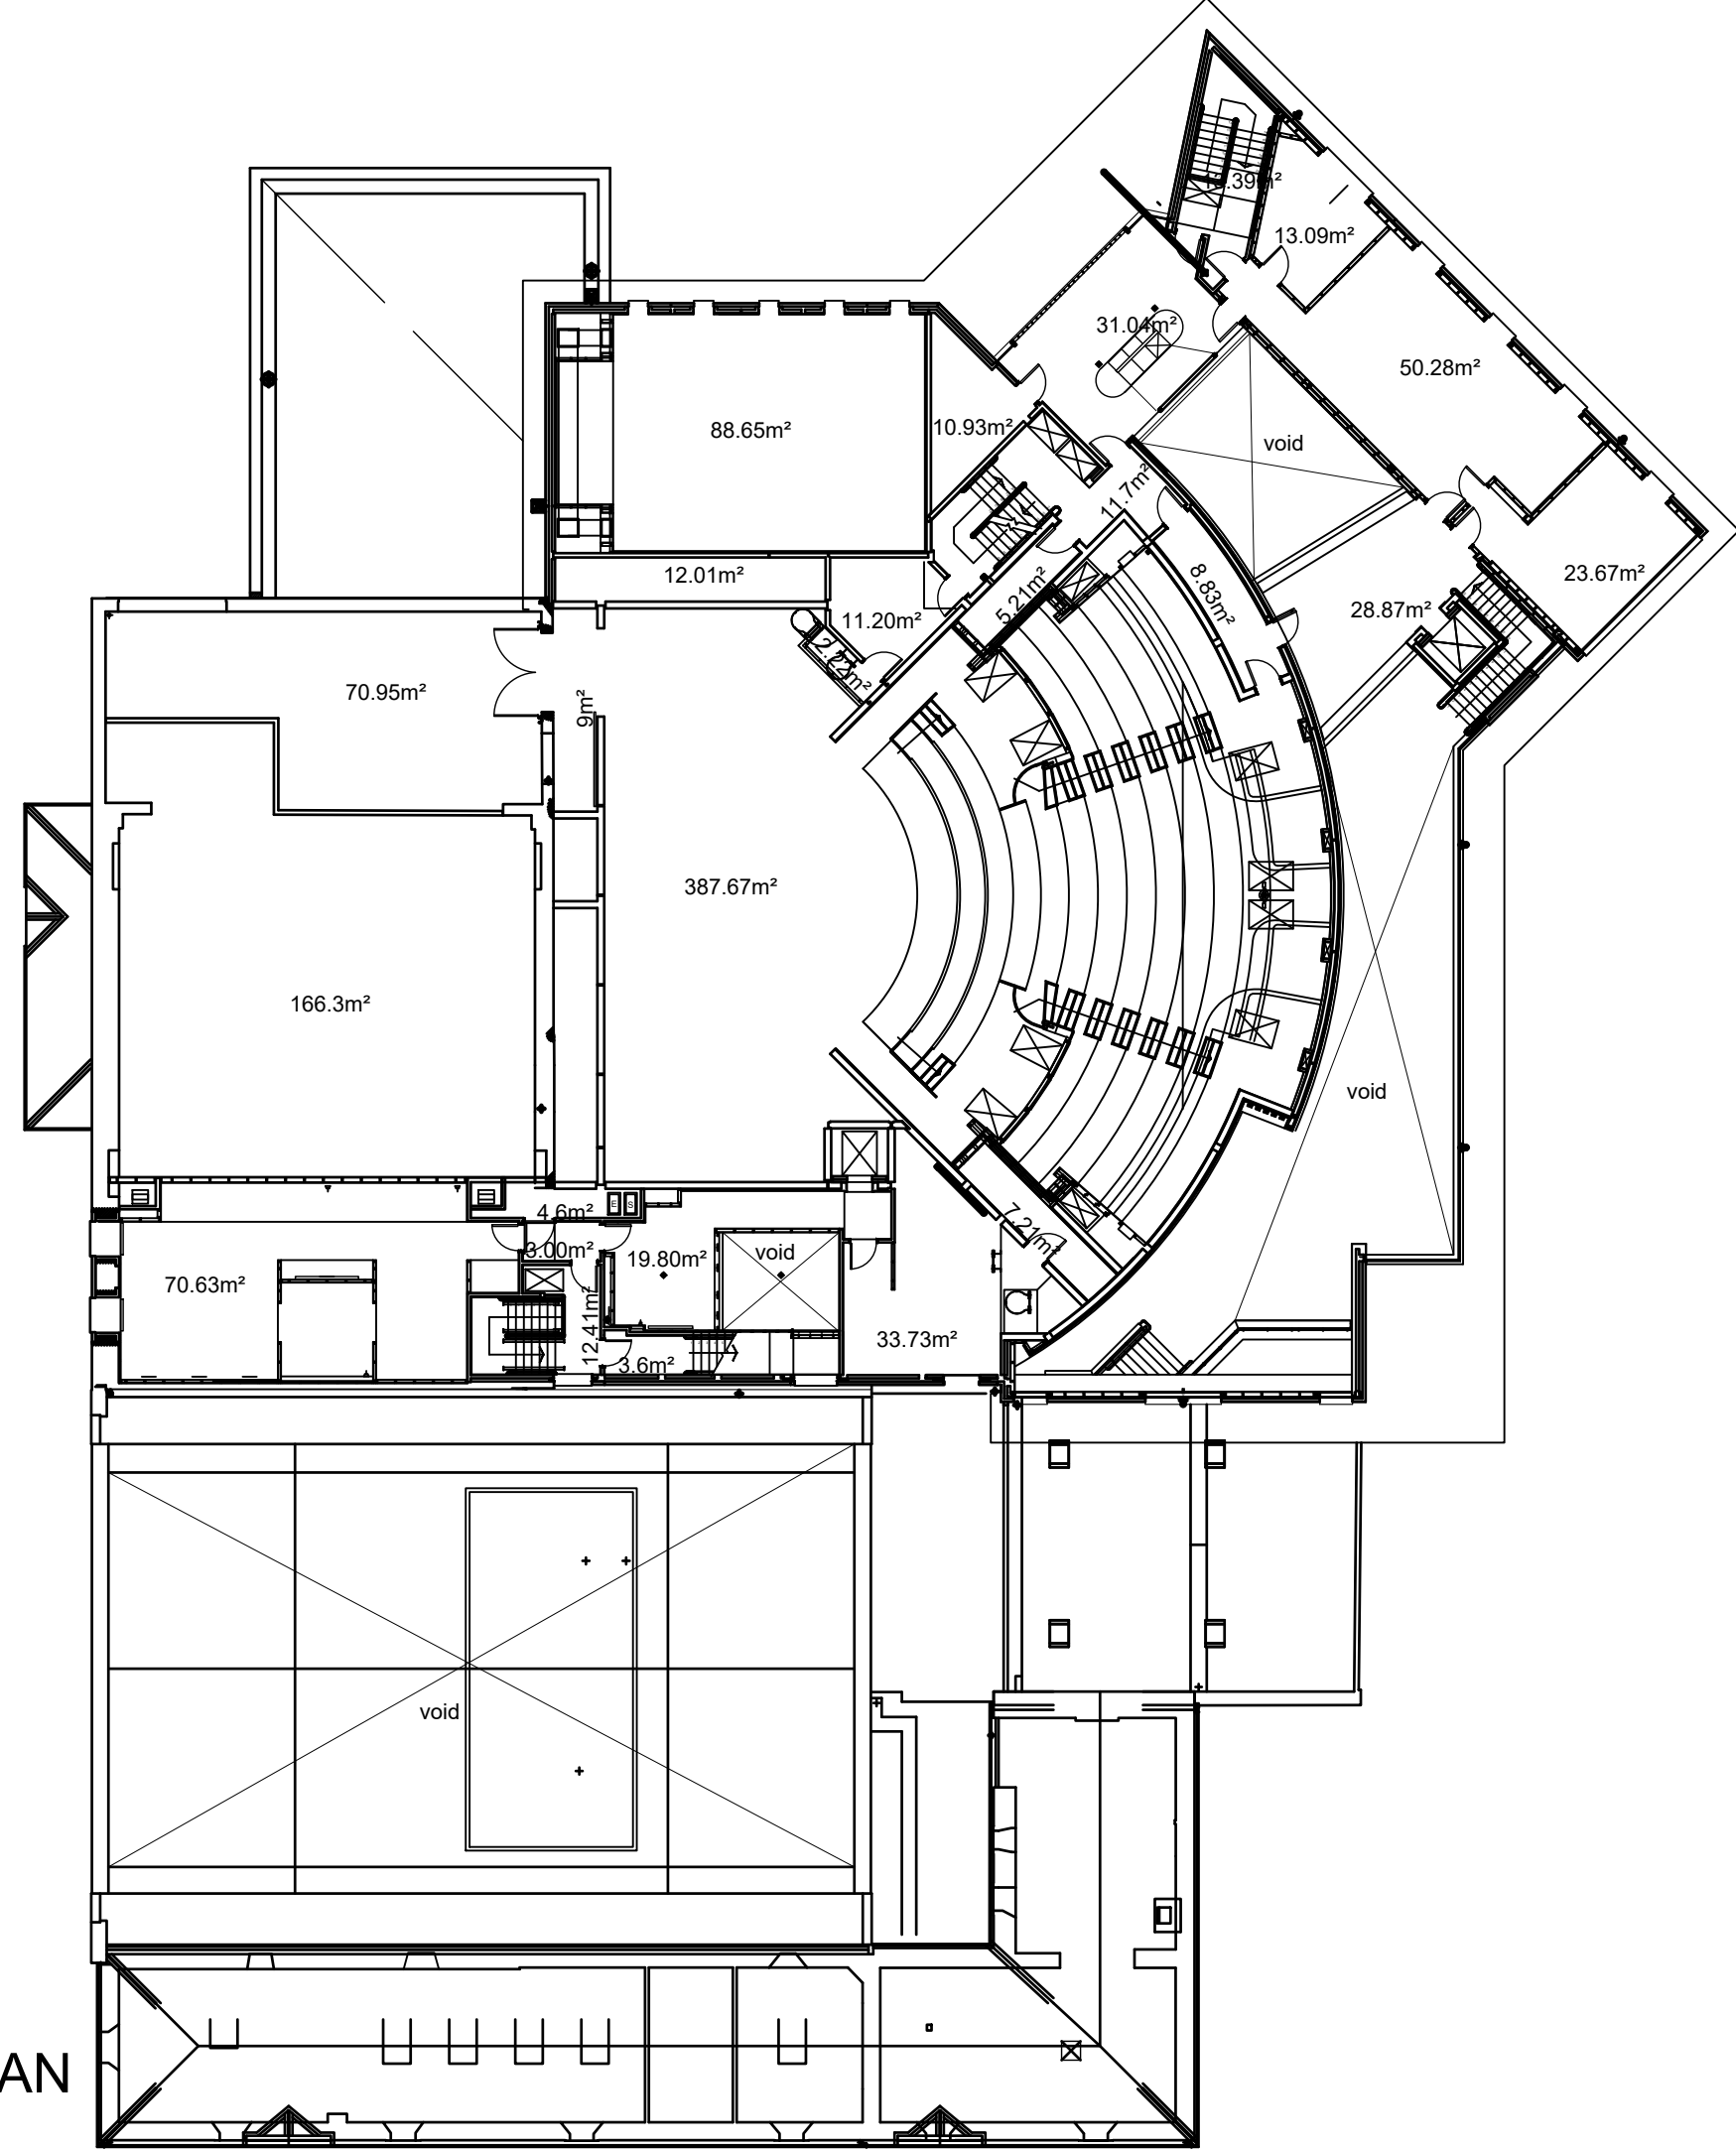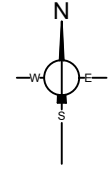

FIRST FLOOR PLAN
GIFA = 4701.6m²



AREA LAYOUT PLAN

Rev	date	details	A3 sheet
Status			AS BUILT
<p>● all dimensions to be checked on site ● do not scale from drawings</p>			
Property Services West Lothian Civic Centre Howden South Road, Livingston EH54 6FF			
Project HOWDEN PARK CENTRE HOWDEN PARK LIVINGSTON			
Drawing FIRST FLOOR PLAN AREA PLAN			
date	JULY'22	scale(s)	1:250
project no.	***	drawing no.	***
drawn	WMC	check	**
Rev	-		

OS Plan reproduced from Ordnance Survey mapping with the permission of the controller of Her Majesty's Stationery Office. Crown Copyright. Unauthorised reproduction infringes Crown copyright and may lead to prosecution or civil proceedings. West Lothian Council copyright license LA9002.




Location Plan

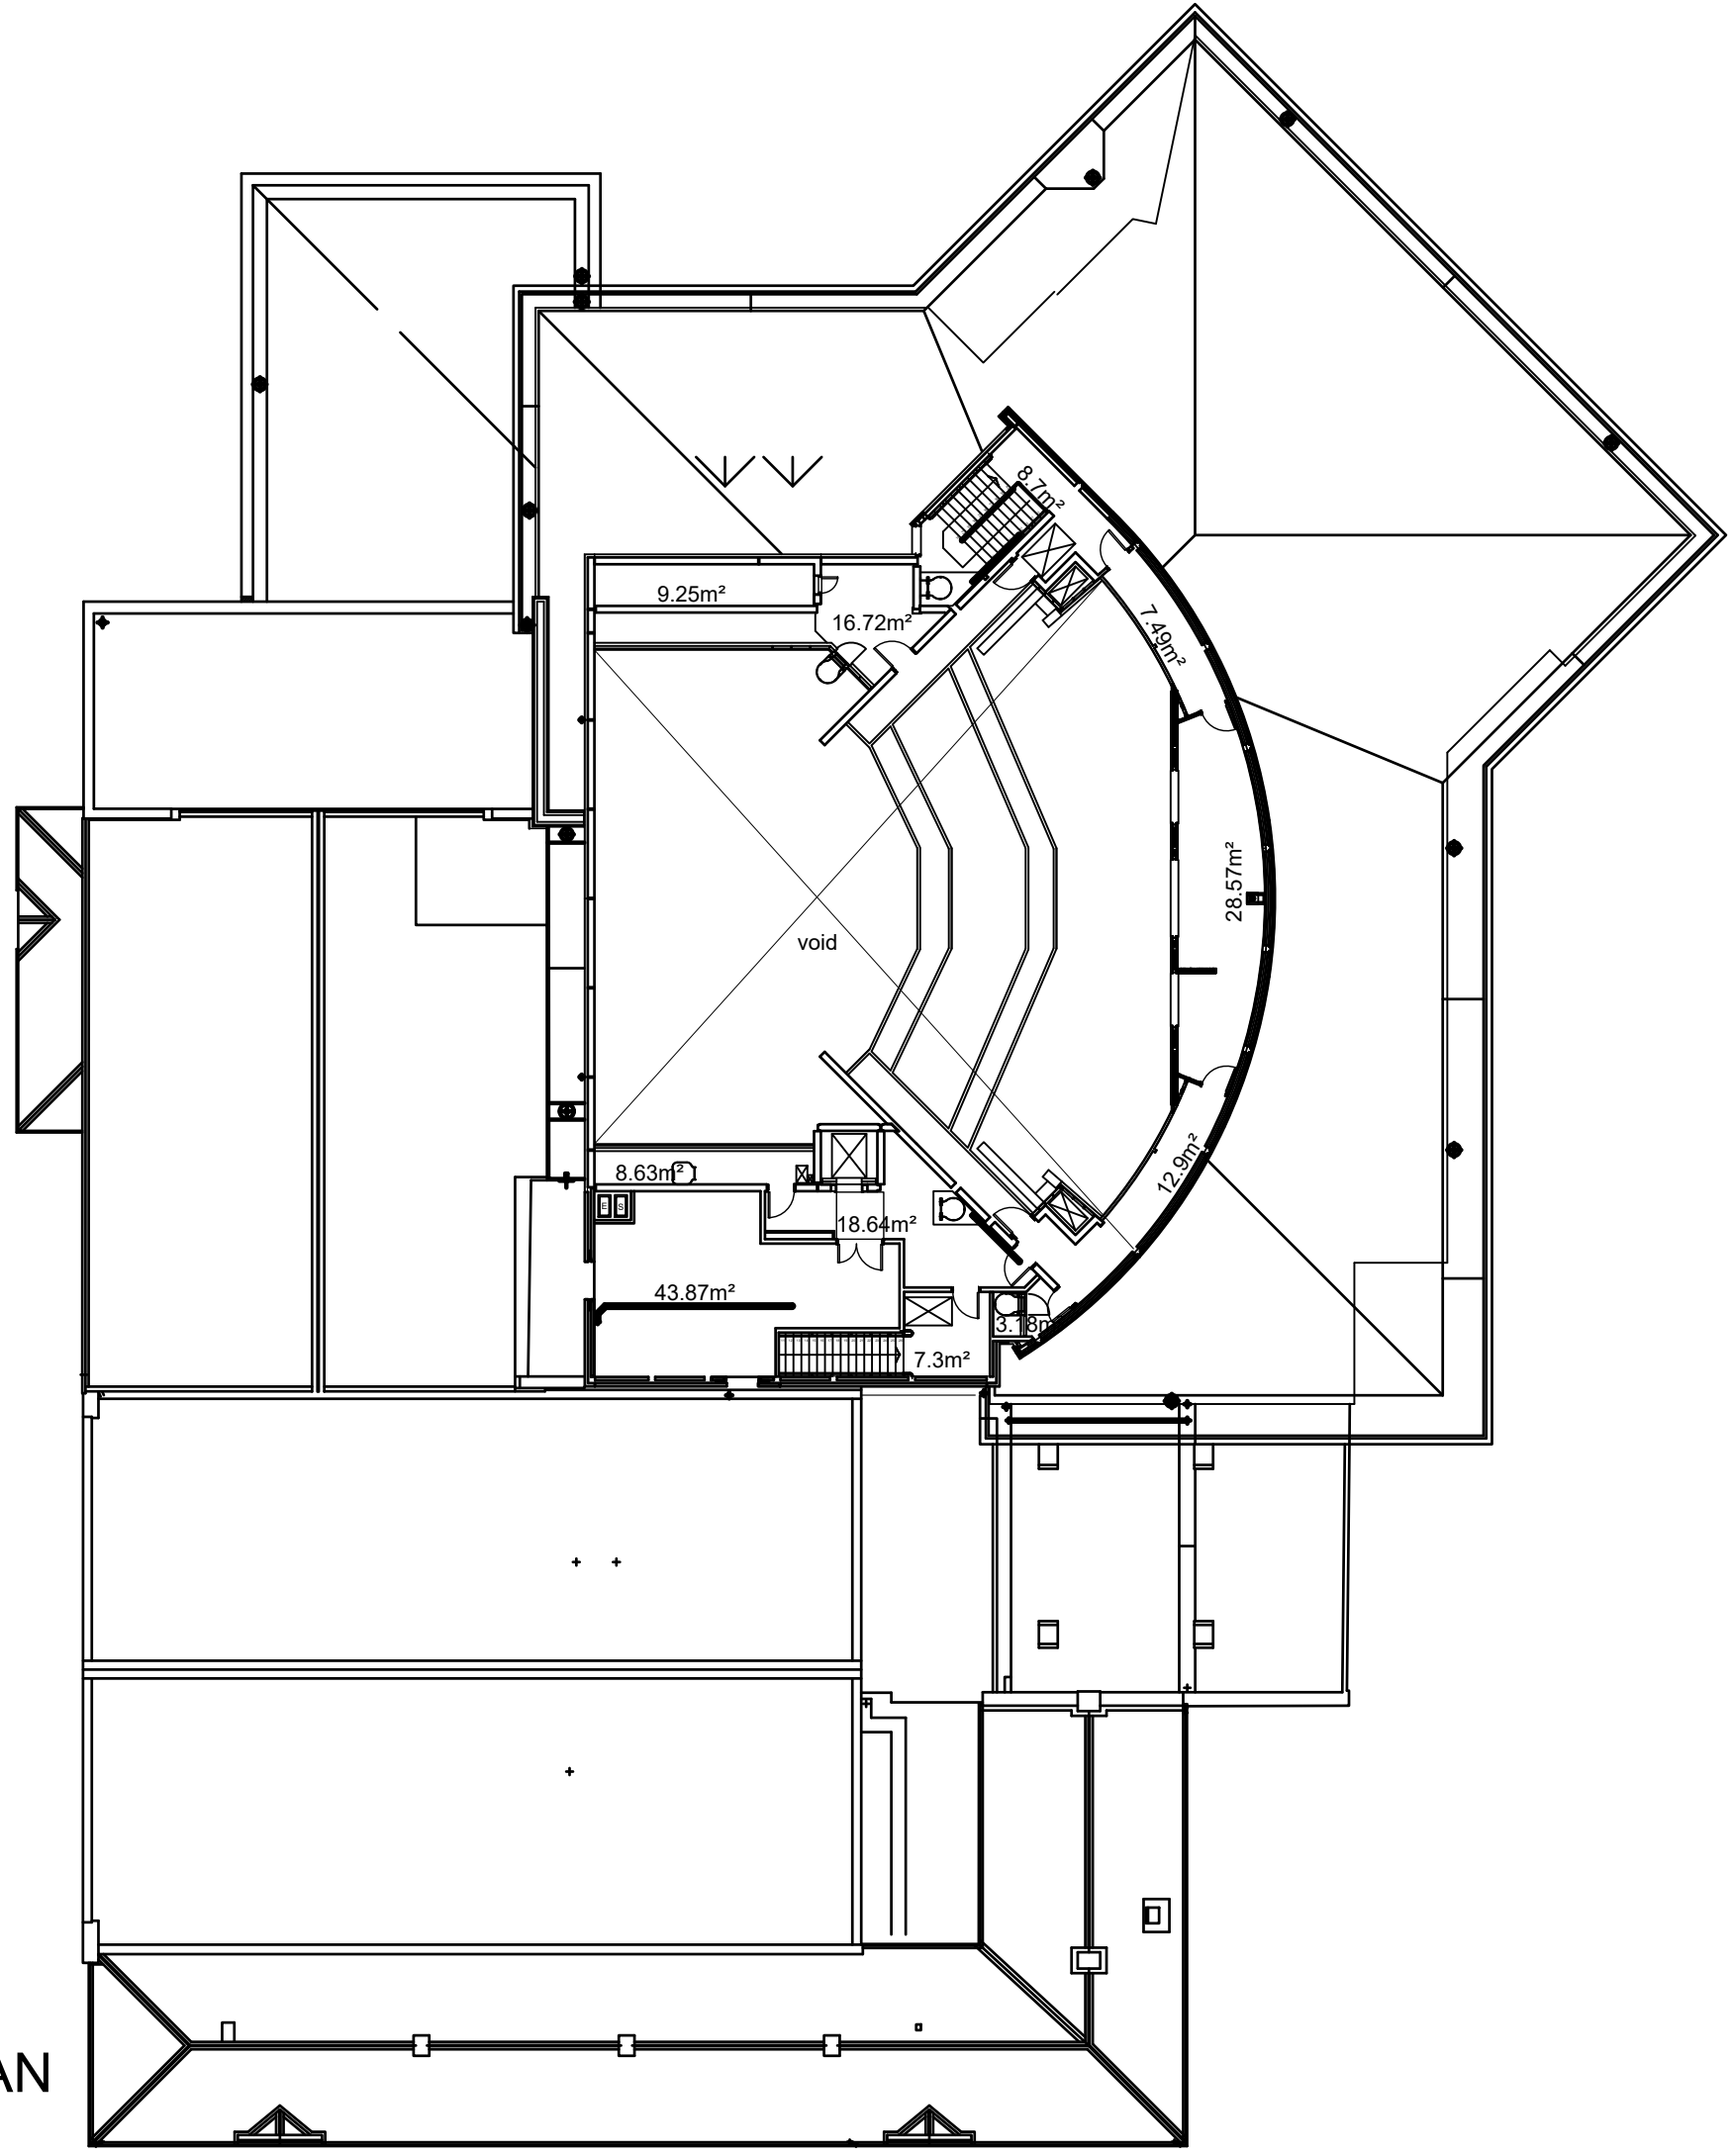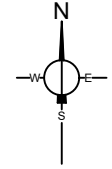

SECOND FLOOR PLAN
GIFA = 4701.6m²

AREA LAYOUT PLAN

Rev	date	details	A3 sheet
Status			AS BUILT
 West Lothian Council <small>● all dimensions to be checked on site ● do not scale from drawings</small>			
Property Services West Lothian Civic Centre Howden South Road, Livingston EH54 6FF			
Project HOWDEN PARK CENTRE HOWDEN PARK LIVINGSTON			
Drawing SECOND FLOOR PLAN AREA PLAN			
date	JULY'22	scale(s)	1:250
project no.	***	drawn	WMC **
		check	**
		Rev	-

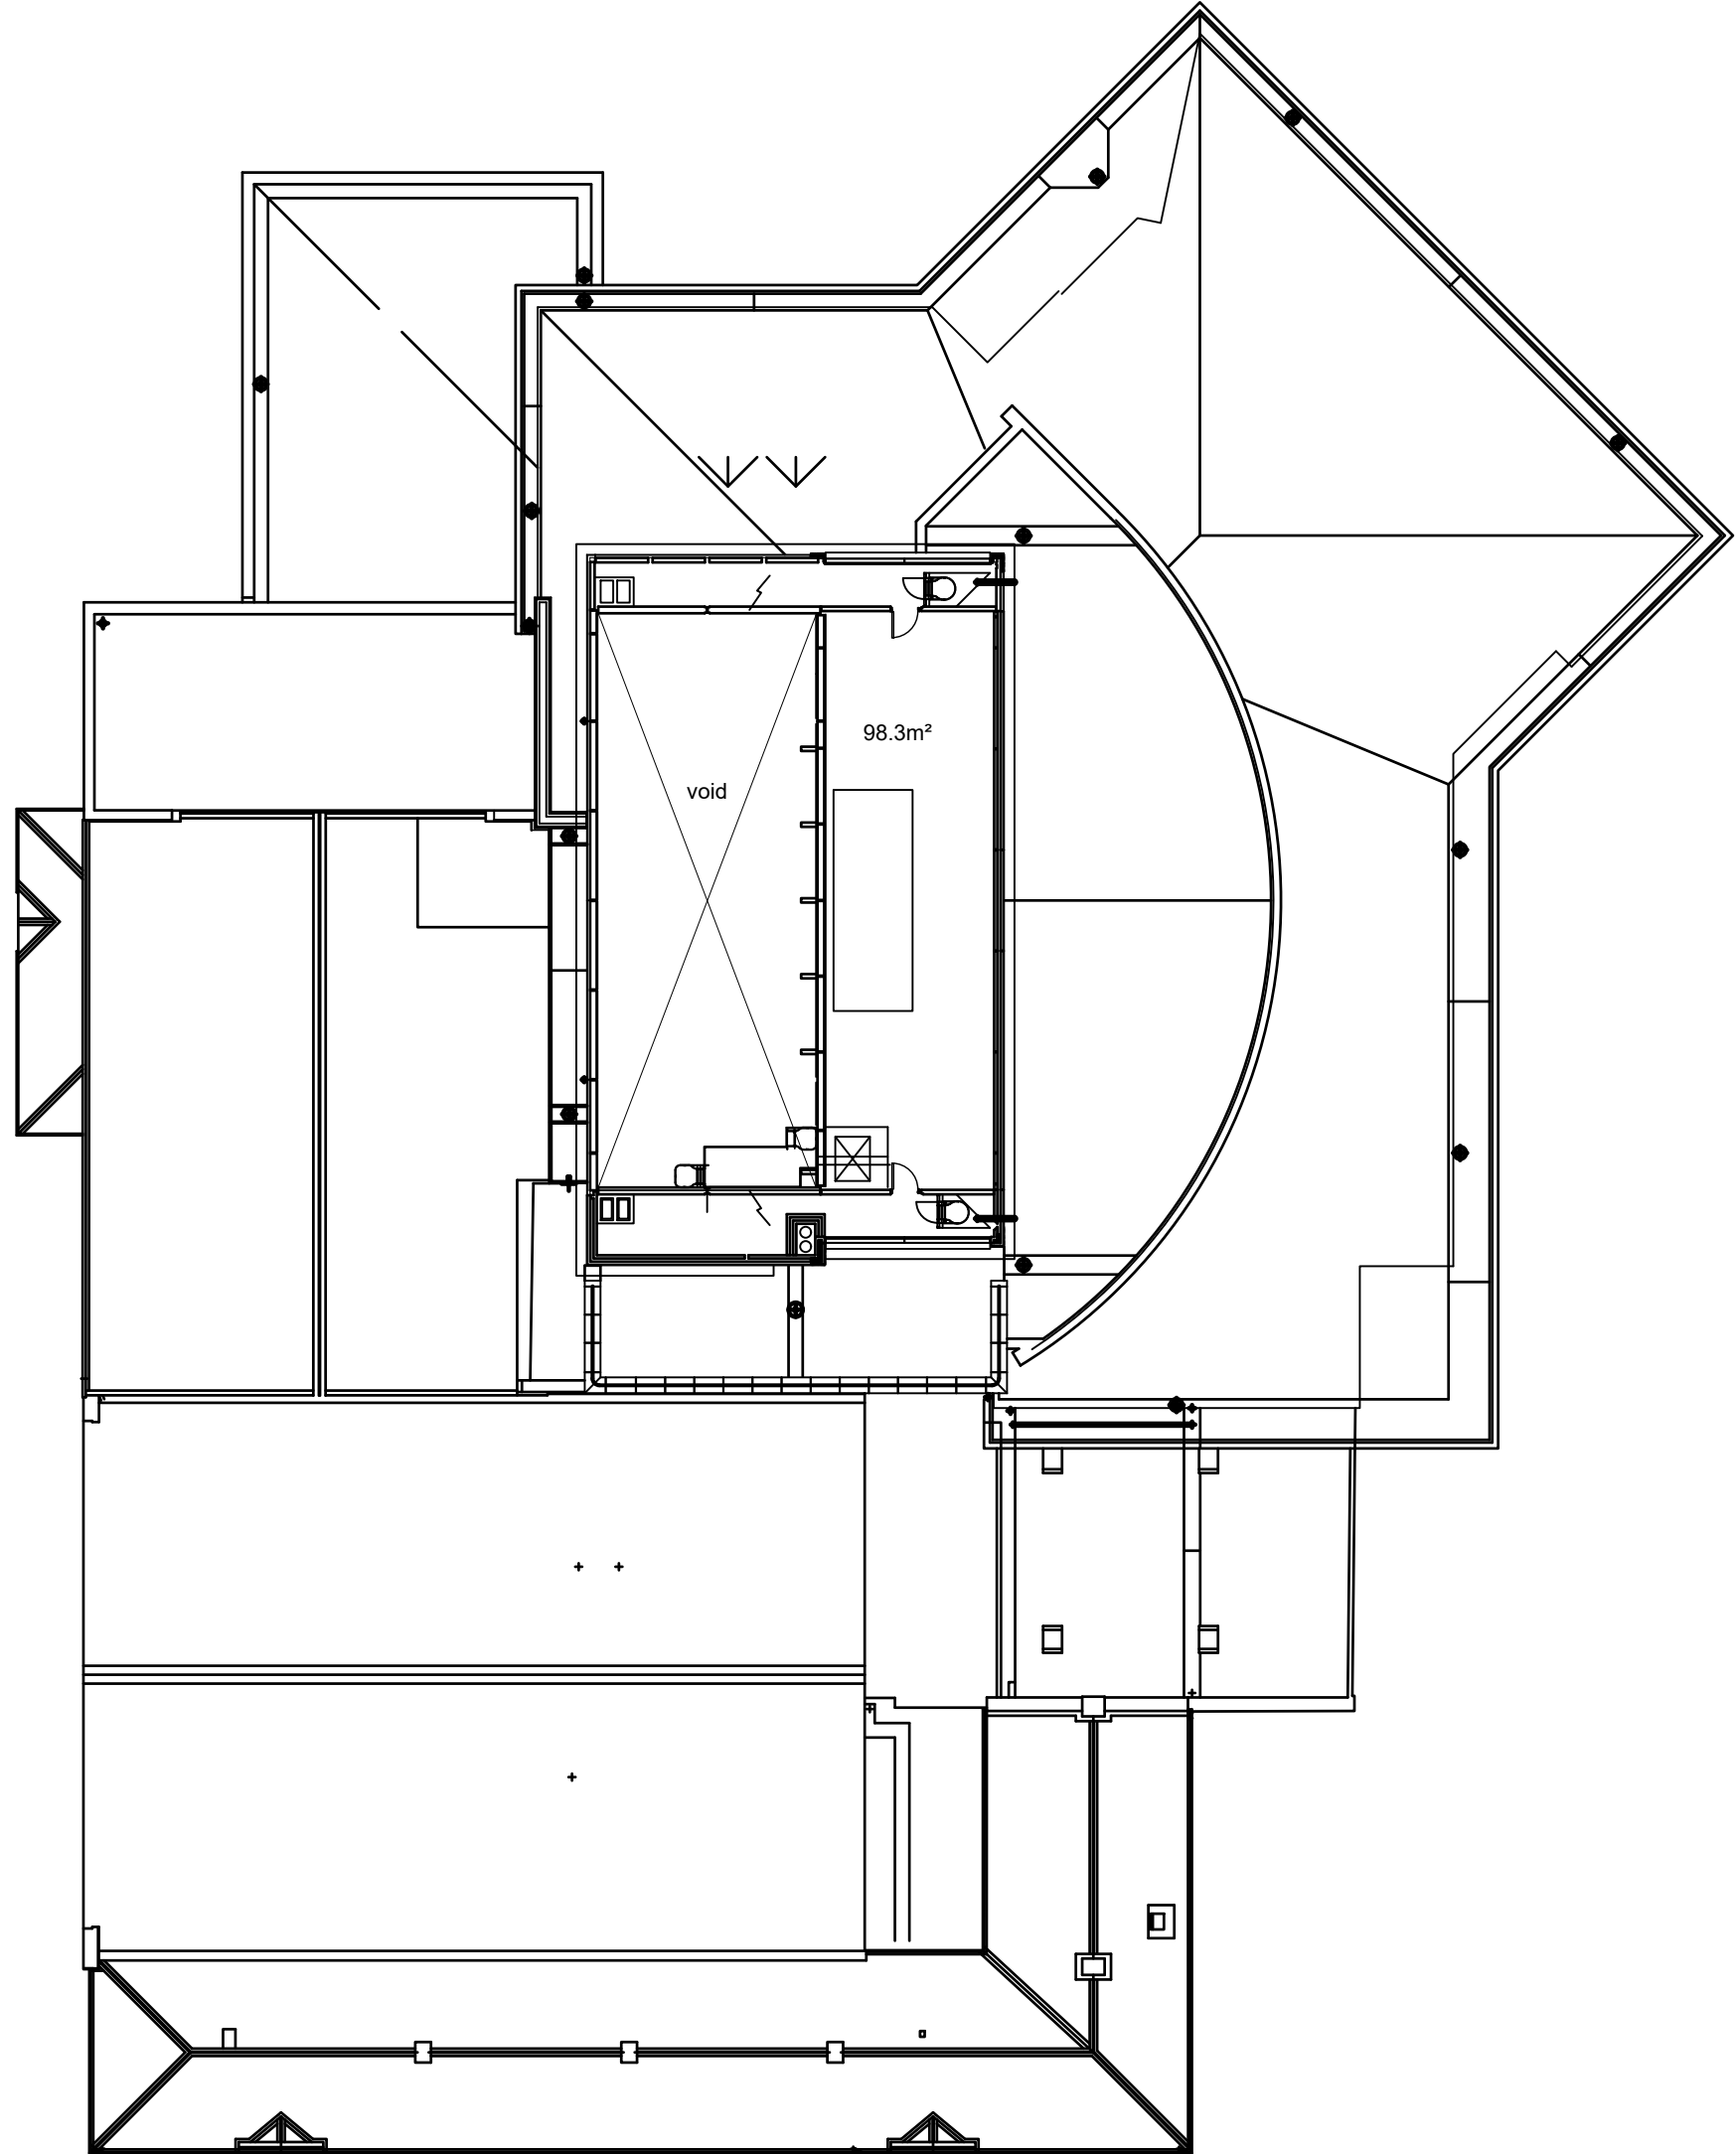



AREA LAYOUT PLAN

THIRD FLOOR PLAN
GIFA = 98.3m²

Rev	date	details	A3 sheet
Status			AS BUILT
<p>● all dimensions to be checked on site ● do not scale from drawings</p>			
Property Services West Lothian Civic Centre Howden South Road, Livingston EH54 6FF			
Project HOWDEN PARK CENTRE HOWDEN PARK LIVINGSTON			
Drawing THIRD FLOOR PLAN AREA PLAN			
date	JULY'22	scale(s)	1:250
project no.	***	drawn	WMC **
		check	**
		Rev	-



Location Plan

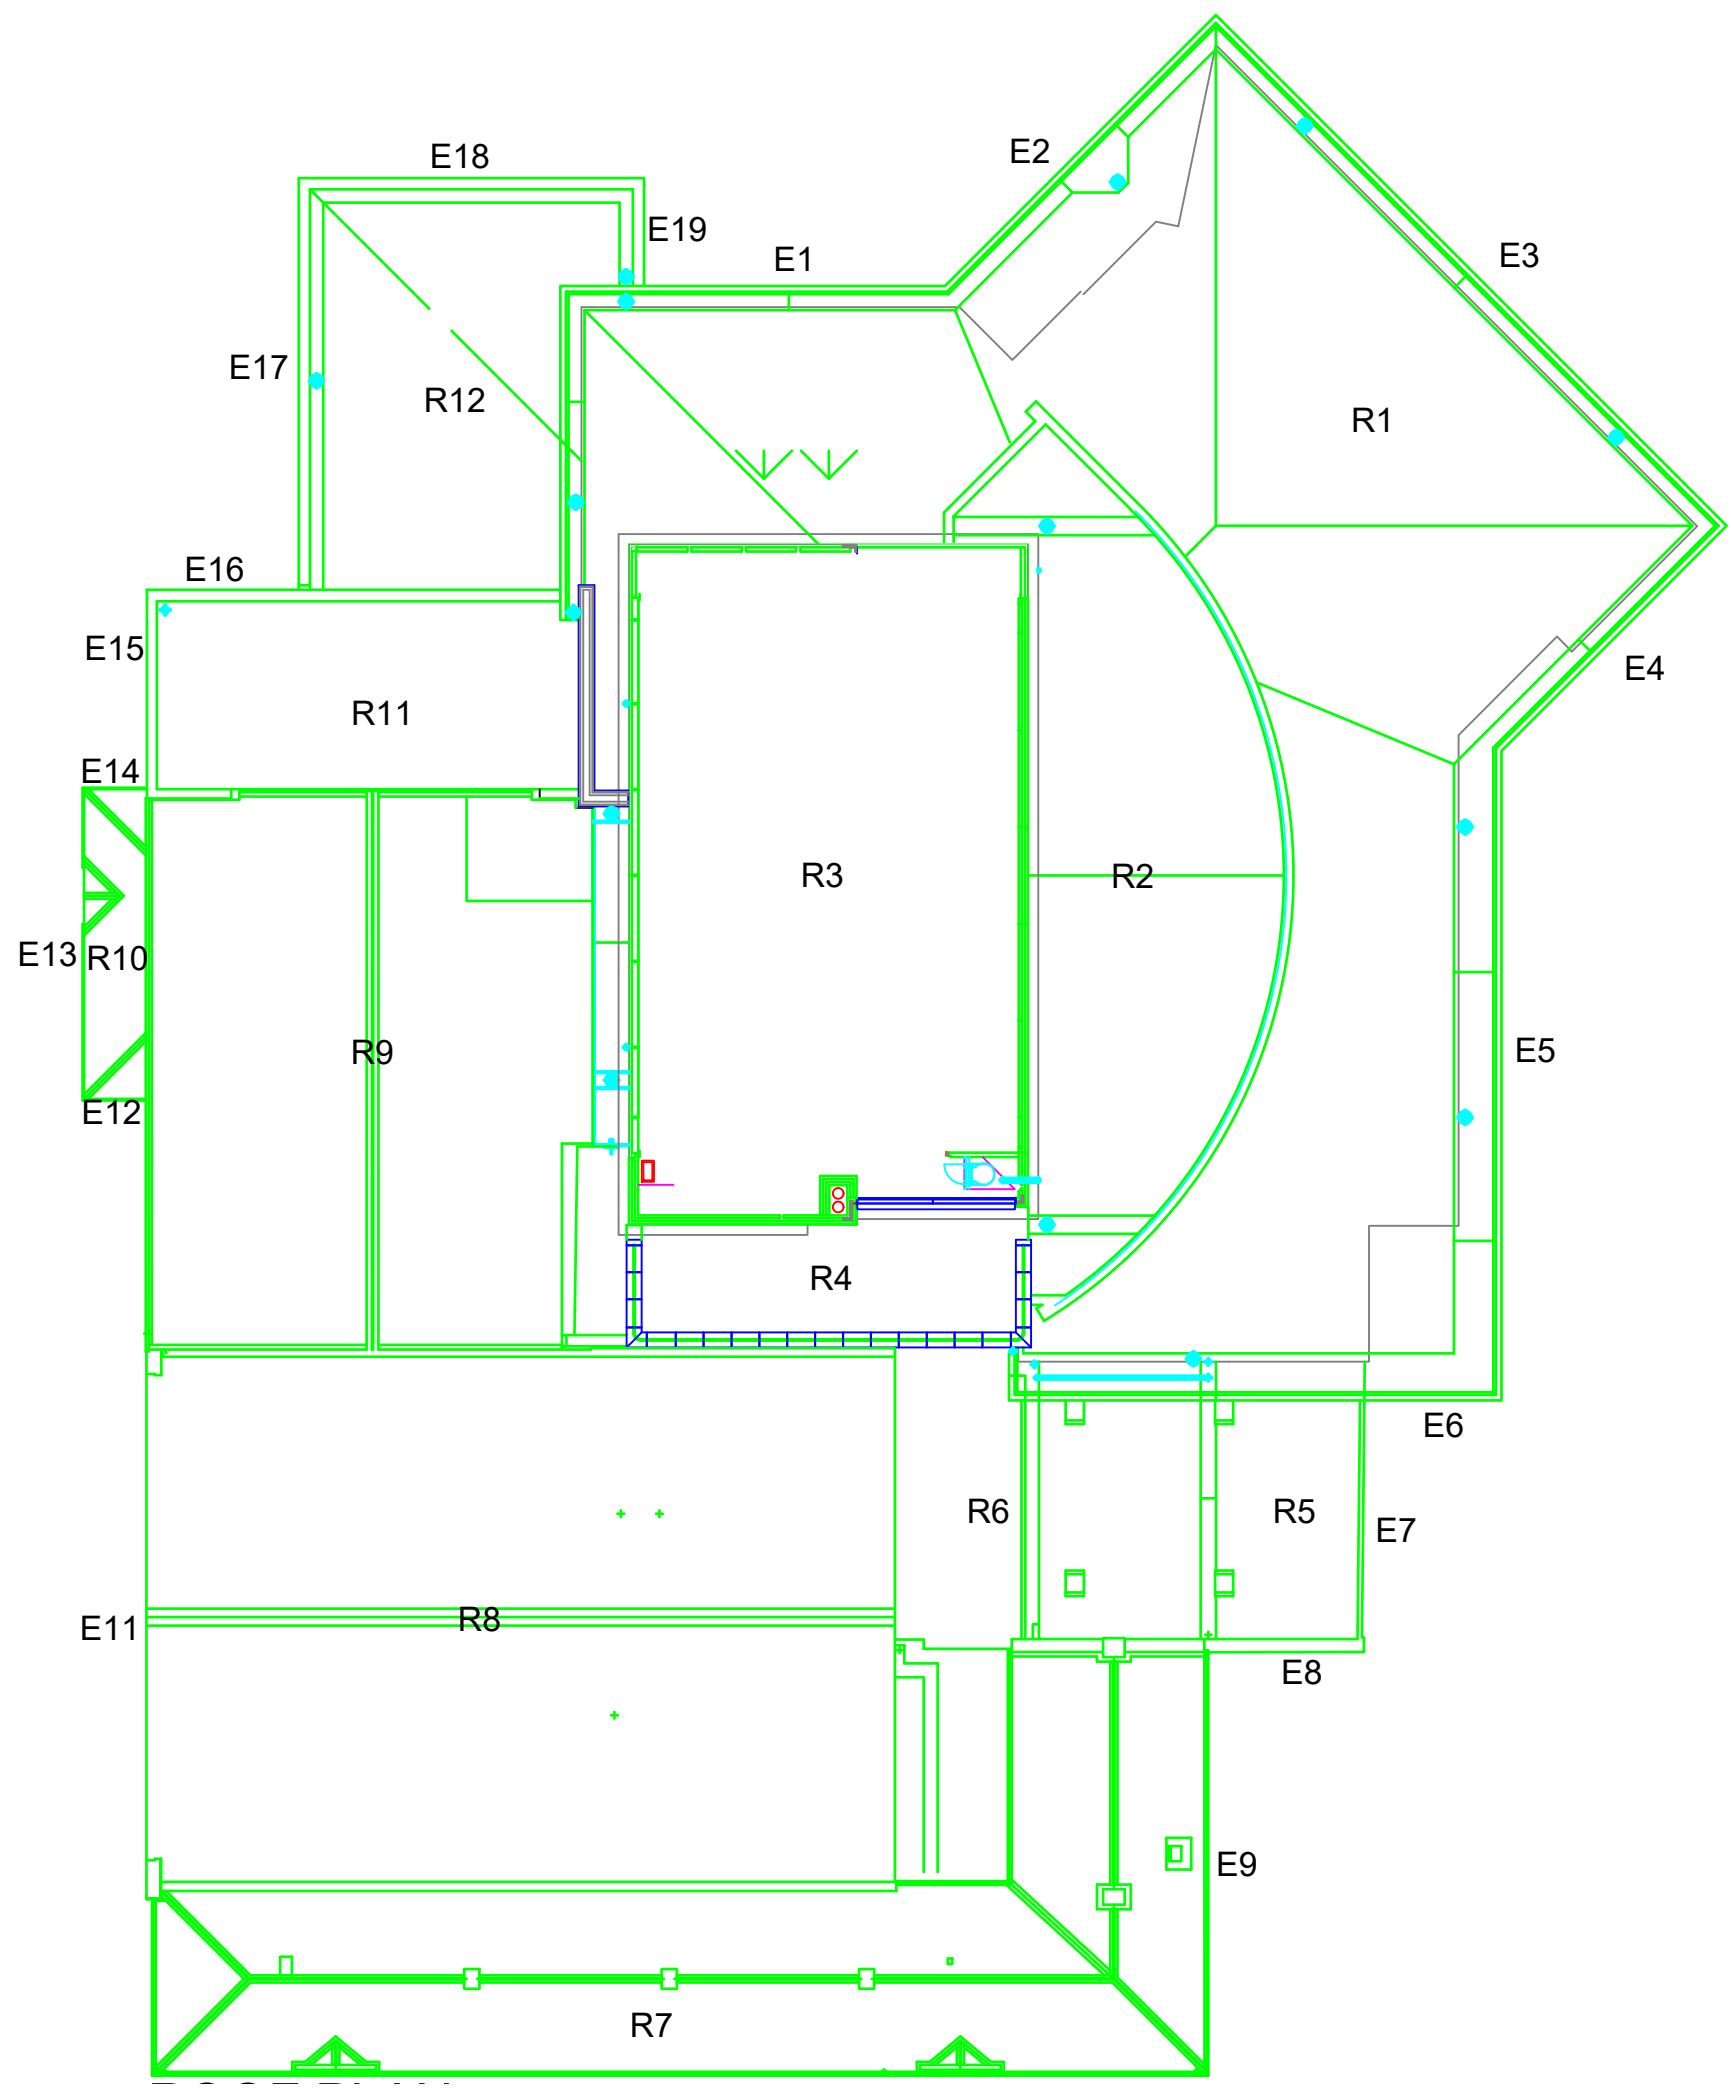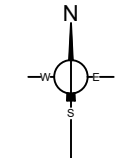

ROOF PLAN

Rev	date	details	A3 sheet
Status	AS BUILT		
● all dimensions to be checked on site ● do not scale from drawings			
Property Services West Lothian Civic Centre Howden South Road, Livingston EH54 6FF			
Project HOWDEN PARK CENTRE HOWDEN PARK LIVINGSTON			
Drawing ROOF PLAN			
date	JULY'22	scale(s)	1:250
project no.	***	drawing no.	***
drawn	WMC	check	**
Rev	-	Rev	-